

15-069-00014-0000


STATE OF KANSAS
STATE CORPORATION COMMISSION

WELL PLUGGING RECORD

Give All Information Completely
Make Required Affidavit
Mail or Deliver Report to:
Conservation Division
State Corporation Commission
800 Bitting Building
Wichita, Kansas

Gray County, Sec. 19 Twp. 29S Rge. 27 (E) (W)

Location as "NE/CNW $\frac{1}{4}$ SW $\frac{1}{4}$ " or footage from lines C SW $\frac{1}{4}$ NE $\frac{1}{4}$
Lease Owner United Producing Company, Inc.
Lease Name Oliva Knoeber Well No. 1
Office Address Drawer #30, Liberal, Kansas
Character of Well (completed as Oil, Gas or Dry Hole) Dry hole
Date well completed August 11 19 53
Application for plugging filed March 15 19 54
Application for plugging approved March 19 54
Plugging commenced April 3 19 54
Plugging completed April 4 19 54
Reason for abandonment of well or producing formation Dry hole

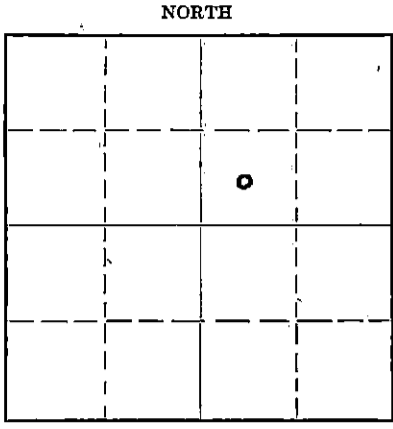

Locate well correctly on above
Section Plat

If a producing well is abandoned, date of last production 19
Was permission obtained from the Conservation Division or its agents before plugging was commenced? Yes

Name of Conservation Agent who supervised plugging of this well Mr. M. A. Rives
Producing formation Depth to top Bottom Total Depth of Well 5160 Feet
Show depth and thickness of all water, oil and gas formations.

OIL, GAS OR WATER RECORDS

CASING RECORD

Formation	Content	From	To	Size	Put In	Pulled Out
Sand & Gravel	Water	0	695	13 3/8"	695	0
"	Water			8 5/8"	2671	765'

Describe in detail the manner in which the well was plugged, indicating where the mud fluid was placed and the method or methods used in introducing it into the hole. If cement or other plugs were used, state the character of same and depth placed, from feet to feet for each plug set.

Plugged surface. Bailed hole to 450'. Set 5' rock bridge. Mixed and pumped in 35 sacks cement. Loaded hole with mud to 20'. Set 5' rock bridge. Mixed and pumped in 15 sacks cement to bottom of cellar.

(If additional description is necessary, use BACK of this sheet)

Name of Plugging Contractor Ace Pipe Pulling Company
Address Great Bend, Kansas

STATE OF Kansas, COUNTY OF Seward, ss.
A. H. Pannell (employee of owner)

being first duly sworn on oath, says: That I have knowledge of the facts, statements, and matters herein contained and the log of the above-described well as filed and that the same are true and correct. So help me God.

(Signature) A. H. Pannell
PO Drawer #30, Liberal, Kansas
(Address)

SUBSCRIBED AND SWORN to before me this 12th day of April, 1954

MY COMMISSION EXPIRES APRIL 16, 1956

My commission expires

Notary Public

28-8890-5
PLUGGING
FRM SEC 19 T 29 R 27
BOOK PAGE 20 LINE 16

RECEIVED
STATE CORPORATION COMMISSION
APR 13 1954 4-13-1954
CONSERVATION DIVISION
Wichita, Kansas

DRILLERS LOG

Operator: United Producing Co., Inc.

Re: Knoeber #1
C SW NE Sec. 19-29-27W
Gray County, Kansas

Contractor: W. J. Coppinger

Casing Record:
13-3/8" set @ 688' w/650 sax.
8-5/8" set @ 2672' w/500 sax.

Surface clay	55
Sand	70
Shale	90
Gravel	110
Shale & Shell	190
Sand	215
Shale & Shell	285
Sand	315
Shale	680
Red Bed & Shale	702
Red Bed	950
Shale & Shell	1040
Anhydrite	1050
Lime	1060
Red Bed, Shale & Shell	1115
Red Bed & Shell	1670
Lime	1705
Shale & Shell	1840
Red Bed & Shale	1890
Lime	1900
Red Bed, Shale & Shell	2080
Red Bed & Shale	2180
Shale & Shell	2300
Red Bed, Shale & Shell	2325
Shale & Shell	2405
Shale	2495
Lime & Shale	2540
Shale	2600
Lime & Shale	2672
Lime	3020
Lime & Shale	3035
Lime	3095
Lime & Shale	3160
Lime	3520
Shale & Lime	3565
Lime	3875
Chalky Lime	3950
Lime	4120
Chalky Lime	4170
Lime	4250
Lime & Shale	4345
Lime	4385
Lime & Shale	4445
Lime	4485
Shale & Lime	4550
Lime	4690
Lime & Shale	4760
Lime	4795

Tops

Anhydrite	1040 (?)
Heebner	4238
Lansing	4430
Morrow	5153
Mississippi	5160
R.T.D.	5460
Comm:	7-9-53
Comp:	8-19-53
Elev.	2664 Gr. Level

RECORDED
STATE OF KANSAS
MAY 17 1954
CONSERVATION DIVISION
Wichita, Kansas

PLUGGING
FILE SEC 19 T 29 R 27W
BOOK PAGE 20 LINE 16

Drillers Log (Continued)

Re: Knoeber #1
C SW NE Sec. 19-29-27W
Gray County, Kansas

Cherty Lime	4830
Shale & Lime	4865
Lime & Shale	4937
Lime	4994
Lime & Shale	5085
Lime	5460
Rotary Total Depth	5460

STATE OF KANSAS)
) ss.
COUNTY OF SEDGWICK)

I, the undersigned, being duly sworn on oath, state that the above statement and log is a true record and log of the well drilled at the location above described.

(signed) W. J. Coppinger

Subscribed and sworn to before me this 20th day of August, 1953.

S E A L

(signed) Mayree Broaddus
Notary Public

My Commission Expires: March 7, 1956

Copied in Liberal Office
United Producing Co., Inc.
March 16, 1954
ems

RECEIVED
AUG 27 1954
REGISTRATION DIVISION
Wichita, Kansas