


STATE OF KANSAS
STATE CORPORATION COMMISSION

WELL PLUGGING RECORD

Give All Information Completely
Make Required Affidavit
Mail or Deliver Report to:
Conservation Division
State Corporation Commission
211 No. Broadway
Wichita, Kansas

Pratt County. Sec. 30 Twp. 29S Rge. (E) 11 (W)
Location as "NE/CNW%SW%" or footage from lines NE/4 SW/4 SE/4
Lease Owner Monsanto Chemical Company
Lease Name Ocim Well No. 1
Office Address P. O. Box 580, Pratt, Kansas
Character of Well (completed as Oil, Gas or Dry Hole) Dry Hole
Date well completed July 23, 1956
Application for plugging filed July 28, 1956
Application for plugging approved July 30, 1956
Plugging commenced August 24, 1956
Plugging completed August 24, 1956
Reason for abandonment of well or producing formation Dry Hole

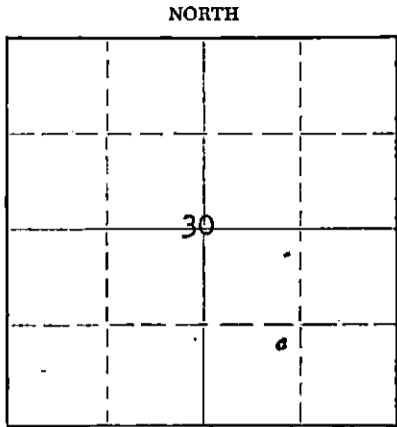

Locate well correctly on above
Section Plat

If a producing well is abandoned, date of last production 19
Was permission obtained from the Conservation Division or its agents before plugging was commenced? Yes

Name of Conservation Agent who supervised plugging of this well M. A. Rives
Producing formation _____ Depth to top _____ Bottom _____ Total Depth of Well 4874 Feet
Show depth and thickness of all water, oil and gas formations.

OIL, GAS OR WATER RECORDS

CASING RECORD

FORMATION	CONTENT	FROM	TO	SIZE	PUT IN	PULLED OUT
				8-5/8"	415'	None
				5-1/2"	4771'	2516'

Describe in detail the manner in which the well was plugged, indicating where the mud fluid was placed and the method or methods used in introducing it into the hole. If cement or other plugs were used, state the character of same and depth placed, from _____ feet to _____ feet for each plug set.

Plugged back total depth = 3869'. Plugged with sand from 3869' to 3830' and 5 sacks of cement from 3830' to 3795'; Heavy mud from 3795' to 290'; Set plug at 290' with 20 sacks of cement on top of plug; Heavy mud to 30'; Set plug at 30' with 10 sacks of cement to base of cellar

PLUGGING
FILE SEC. 30 T. 29 R. 11W
BOOK PAGE 24 LINE 23

RECEIVED
STATE CORPORATION COMMISSION
AUG 25 1956 08-25-56

(If additional description is necessary, use BACK of this sheet)
Name of Plugging Contractor West Supply Company
Address Chase, Kansas

STATE OF KANSAS, COUNTY OF PRATT, ss.
J. B. Gibbs (employee of owner) or (owner or operator) of the above-described well, being first duly sworn on oath, says: That I have knowledge of the facts, statements, and matters herein contained and the log of the above-described well as filed and that the same are true and correct. So help me God.

(Signature) *J. B. Gibbs*
P. O. Box 580, Pratt, Kansas
(Address)

SUBSCRIBED AND SWORN TO before me this 24th day of August, 1956

My commission expires September 19, 1959
Merle J. Combs
Notary Public.



WELL LOG

COMPANY **LION OIL COMPANY**

SEC. 30 T. 29S R. 11W

FARM **OCIM**

NO. **1**

LOC. **NE, SW, SE**


TOTAL DEPTH **4870'**

COUNTY **PRATT**

COMM. **June 23, 1956**

COMP. **July 14, 1956**

CONTRACTOR **GARVEY DRILLING COMPANY**

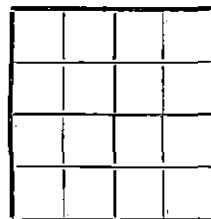

CASING **8 5/8" @ 421' W/325 sax.**
5 1/2" @ 4774.80' W/300 sax.

ELEVATION **1857' DF**

PRODUCTION

FIGURES INDICATE BOTTOM OF FORMATIONS

75	Surface soil & clay	
145	Sand	Heebner 3677'
265	Red bed	Douglas 3710'
285	Anhydrite	B. Lime 3858'
423	Shale & shells	Lansing 3871'
1136	Shale, red bed & shells	Kinderhook 4458'
1460	Shale & shells	Viola 4623'
1580	Salt & shale	Simpson 4696'
1750	Shale & shells	Arbuckle 4791'
1870	Lime	
2067	Lime & shale	
2305	Lime	
3185	Lime & shale	
3563	Lime	
3591	Lime & shale	
3651	Lime	
3797	Shale & lime	
4465	Lime	
4625	Shale & lime	
4658	Cherty lime & shale	
4680	Lime	
4705	Lime & shale	
4751	Sand & shale	
4781	Sand, shale & lime	
4870	Lime	
4870	T. D.	

PLUGGING
 FILE SEC. 30 T. 29 R. 11W
 BOOK PAGE 94 LINE 33

RECEIVED
 STATE CORPORATION COMMISSION
 AUG 9 1956
 CONSERVATION DIVISION
 Wichita, Kansas

State of KANSAS }
 County of BARTON } ss:

I, Verne A. Morris of Garvey Drilling Co.

upon oath state that the above and foregoing is a true and correct copy of the log of the #1 Ocim well

Verne A. Morris

Subscribed and sworn to before me this 2nd day of August 19 56

My Commission Expires: July 11, 1960

Zed S. Brewer
 NOTARY PUBLIC