

STATE OF KANSAS
STATE CORPORATION COMMISSION

WELL PLUGGING RECORD

Give All Information Completely
Make Required Affidavit
Mail or Deliver Report to
Conservation Division
State Corporation Comm.
245 North Water
Wichita, KS 67202

Pratt County, Sec. 30 Twp. 29S Rge. 11W E/W
Location as "NE/CNW $\frac{1}{4}$ SW $\frac{1}{4}$ " or footage from lines
SE/4 (75' SW SE)

Lease Owner Rupe Oil Co., Inc.
Lease Name McGuire Well No. 1


Office Address P. O. Box 2273, Wichita, Kansas
Character of Well (Completed as Oil, Gas or Dry Hole)
dry hole

Date Well completed July 29 19 79
Application for plugging filed July 29 19 79
Application for plugging approved July 29 19 79
Plugging commenced July 29 19 79
Plugging completed July 29 19 79

Reason for abandonment of well or producing formation
dry
If a producing well is abandoned, date of last production
19

Was permission obtained from the Conservation Division or
its agents before plugging was commenced? yes

Name of Conservation Agent who supervised plugging of this well Wm. T. Owan
Producing formation _____ Depth to top _____ Bottom _____ Total Depth of Well 4090
Show depth and thickness of all water, oil and gas formations.

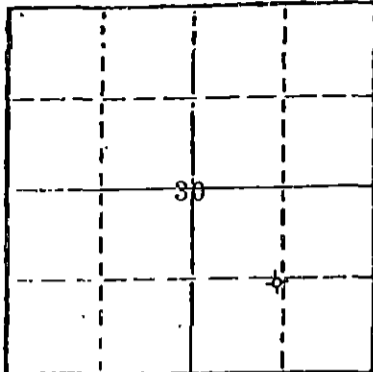

Locate well correctly on above
Section Plat

OIL, GAS OR WATER RECORDS

CASING RECORD

FORMATION	CONTENT	FROM	TO	SIZE	PUT IN	PULLED OUT

Describe in detail the manner in which the well was plugged, indicating where the mud fluid
was placed and the method or methods used in introducing it into the hold. If cement or other
plugs were used, state the character of same and depth placed, from _____ feet to
_____ feet for each plug set.

First plug set at 540' with 50 sacks.
Second plug set at 270' with 40 sacks
Third plug set at 40' with 12 sacks
Three sacks in the rat hole

STATE RECEIVED
CORPORATION COMMISSION
AUG 15 1979
Wichita, Kansas

(If additional description is necessary use BACK of this sheet)

Name of Plugging Contractor Union Drilling Co., Inc.

STATE OF Kansas COUNTY OF Sedgwick
R. D. Messinger (employee of owner) or (owner or operator)

of the above-described well, being first duly sworn on oath, says: That I have knowledge of
the facts, statements, and matters herein contained and the log of the above-described well
as filed and that the same are true and correct. So help me God.

(Signature) R. D. Messinger
505 Union Center, Wichita, Kansas
(Address)

SUBSCRIBED AND SWORN TO before me this 1st day of August, 19 79

Cynthia L. Romey
Notary Public.

Commission expires 6-2-82



CONTRACTORS WELL LOG

OPERATOR:
CONTRACTOR:
WELL NAME:
LOCATION:

Rupe Oil Co., Inc.
Union Drilling Co., Inc.
#1 McGuire
SE/4 Section 30-29S-11W
Pratt County, Kansas
July 14, 1979
July 29, 1979

COMMENCED:
COMPLETED:

0	280	Surface soil	Set 8-5/8" @280' w/200 sx.
280	1419	Shale	
1419	1880	Shale and lime	
1880	3914	Lime and shale	
3914	3935	Shale and lime	
3935	4090	Lime and shale	
	4090	T. D.	

We certify that the above and foregoing is a true and correct copy of the log on the #1 McGuire, SE/4 Section 30-29S-11W, Pratt County, Kansas.

UNION DRILLING CO., INC.


R. D. Messinger
R. D. Messinger

STATE OF KANSAS)
) SS
COUNTY OF SEDGWICK)

Subscribed and sworn to before me, a Notary Public, the aforesaid County and State as of this 1st day of August, 1979.

My appointment expires:

Cynthia L. Romey
Cynthia L. Romey-Notary Public

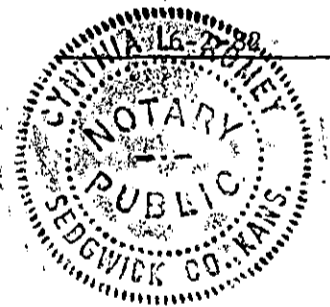

RECEIVED
STATE CORPORATION COMMISSION

AUG 15 1979

CONSERVATION DIVISION
Wichita, Kansas