


WELL PLUGGING RECORD

STATE OF KANSAS STATE CORPORATION COMMISSION

Give All Information Completely Make Required Affidavit Mail or Deliver Report to: Conservation Division State Corporation Commission 211 No. Broadway Wichita, Kansas

Pratt County. Sec. 30 Twp. 29S Rge. 11W (E) (W) Location as "NE/CNWxSWx" or footage from lines C SW/4, NW/4 Lease Owner Austral Oil Company Incorporated Lease Name John H. Collett Well No. 1 Office Address 300 San Jacinto Building, Houston, Texas Character of Well (completed as Oil, Gas or Dry Hole) Dry Hole Date well completed April 10 1964 Application for plugging filed Verbal Approval April 4 1964 Application for plugging approved April 4 1964 Plugging commenced April 4 1964 Plugging completed April 4 1964 Reason for abandonment of well or producing formation Dry Hole

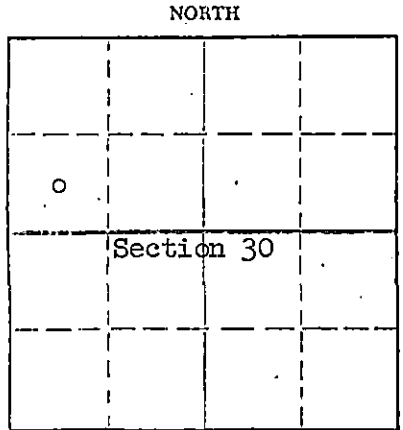

Locate well correctly on above Section Plat

If a producing well is abandoned, date of last production 19 Was permission obtained from the Conservation Division or its agents before plugging was commenced? Yes

Name of Conservation Agent who supervised plugging of this well A. Elving, Box 248, Pratt, Kansas Producing formation None Depth to top Bottom Total Depth of Well 4,751 Feet 4,749 logged

Table with 7 columns: FORMATION, CONTENT, FROM, TO, SIZE, PUT IN, PULLED OUT. Row 1: See Attached Drillers Well Log, Surface, 416, 8-5/8", 416, None.

Describe in detail the manner in which the well was plugged, indicating where the mud fluid was placed and the method or methods used in introducing it into the hole. If cement or other plugs were used, state the character of same and depth placed, from feet to feet for each plug set.

Bottom plug set at 255 feet with 1/2 sx Halls and 25 sx cement. Mud up to 40 feet at 9.9 wt. Set bridge plug at 40 feet with 1/2 sx Halls and 10 sx cement. Plug down at 4:00 p.m. Steel cap welded on 8-5/8" casing.

RECEIVED STATE CORPORATION COMMISSION 5-11-1964 MAY 11 1964

Name of Plugging Contractor Gabbert-Jones, Inc. Address 514 Orpheum Building, Wichita, Kansas

STATE OF Texas COUNTY OF Harris ss. D. D. Delaney (employee of owner) or (owner or operator) of the above-described well, being first duly sworn on oath, says: That I have knowledge of the facts, statements, and matters herein contained and the log of the above-described well as filed and that the same are true and correct. So help me God.

(Signature) [Signature] 300 San Jacinto Building, Houston, Texas (Address)

SUBSCRIBED AND SWORN TO before me this 6th day of May, 1964

My commission expires June 1, 1965 C. G. PEARCE Notary Public. Notary Public in and for Harris County, Texas My Commission Expires June 1, 1965

GABBERT-JONES INC.
WICHITA, KANSAS
DRILLERS WELL LOG


JOHN H. COLLETT #1
C SW NW SECTION 30-29S-11W
PRATT COUNTY, KANSAS

COMMENCED MARCH 28, 1964
COMPLETED APRIL 10, 1964

OPERATOR - AUSTRAL OIL COMPANY

<u>DEPTH</u>		<u>FORMATION</u>	<u>REMARKS</u>
FROM	To		
0	165	SHALE & SAND	RAN 13 JOINTS 8-5/8" CASING, SET @ 416' W/ 300 SACKS CEMENT
165	416	RED BED	
416	1410	SHALE	
1410	1775	SHALE, SHELL & LIME	
1775	1985	SHALE & LIME	
1985	2100	LIME	
2100	2685	LIME & SHALE	
2685	2965	SHALE	
2965	3160	LIME	
3160	3455	LIME & SHALE	
3455	3555	LIME	
3555	3725	SHALE & LIME	
3725	4455	LIME	
4455	4539	SHALE & LIME	
4539	4573	VIOLA, LIME & CHERT	
4573	4630	LIME & CHERT	
4630	4690	SIMPSON	
4690	4729	SHALE & LIME	
4729	4751	LIME	
4751	TD		DRY & ABANDONED

I, E. E. HALL, CERTIFY THIS IS A CORRECT COPY OF THE DRILLER'S LOG FOR THE WELL DRILLED IN THE C SW NW SECTION 30-29S-11W, PRATT COUNTY, KANSAS, TO THE BEST OF MY KNOWLEDGE AND BELIEF.

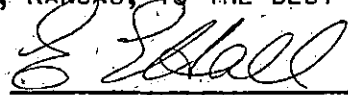


E. E. HALL

STATE OF KANSAS)
) SS
COUNTY OF SEDGWICK)

BEFORE ME, THE UNDERSIGNED, A NOTARY PUBLIC WITHIN AND FOR SAID COUNTY AND STATE ON THIS 13TH DAY OF APRIL, 1964, PERSONALLY APPEARED E. E. HALL TO ME PERSONALLY KNOWN TO BE THE IDENTICAL PERSON WHO EXECUTED THE WITHIN AND FOREGOING INSTRUMENT AND ACKNOWLEDGED TO ME THAT HE EXECUTED THE SAME AS HIS FREE AND VOLUNTARY ACT AND DEED FOR THE USES AND PURPOSES THEREIN SET FORTH.

IN WITNESS WHEREOF, I HAVE HEREUNTO SET MY HAND AND OFFICIAL SEAL THE DAY AND YEAR LAST ABOVE WRITTEN.

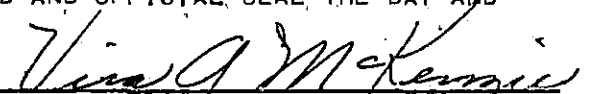

VIRA A. MCKENZIE, NOTARY PUBLIC

MY COMMISSION EXPIRES OCTOBER 2, 1967

RECEIVED
STATE CORPORATION COMMISSION

MAY 11 1964

CONSERVATION DIVISION
Wichita, Kansas