


STATE OF KANSAS  
STATE CORPORATION COMMISSION

WELL PLUGGING RECORD

Give All Information Completely  
Make Required Affidavit  
Mail or Deliver Report to:  
Conservation Division  
State Corporation Commission  
211 No. Broadway  
Wichita, Kansas

Pratt County, Sec. 14 Twp. 29S Rge. 11 (E) 11 (W)  
Location as "NE/CNW/SW" or footage from lines NE/4 NE/4 NW/4  
Lease Owner Messman-Rinehart Oil Company  
Lease Name Hiskett Well No. 1  
Office Address 518 Petroleum Building, Wichita, Kansas  
Character of Well (completed as Oil, Gas or Dry Hole) Dry Hole  
Date well completed November 7 19 58  
Application for plugging filed November 7 19 58  
Application for plugging approved November 7 19 58  
Plugging commenced November 7 19 58  
Plugging completed November 7 19 58  
Reason for abandonment of well or producing formation Dry

NORTH

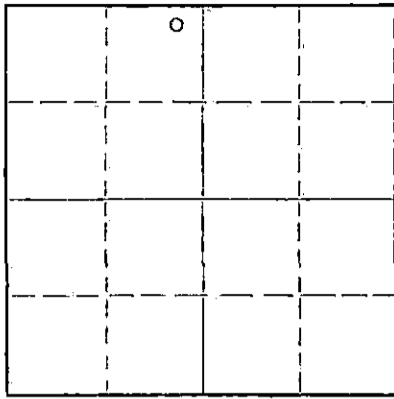

Locate well correctly on above  
Section Plat

If a producing well is abandoned, date of last production 19  
Was permission obtained from the Conservation Division or its agents before plugging was commenced? yes

Name of Conservation Agent who supervised plugging of this well W. L. Lackamp  
Producing formation \_\_\_\_\_ Depth to top \_\_\_\_\_ Bottom \_\_\_\_\_ Total Depth of Well 4710 Feet  
Show depth and thickness of all water, oil and gas formations.

OIL, GAS OR WATER RECORDS

CASING RECORD

FORMATION	CONTENT	FROM	TO	SIZE	PUT IN	PULLED OUT
				10-3/4"	196'	none

Describe in detail the manner in which the well was plugged, indicating where the mud fluid was placed and the method or methods used in introducing it into the hole. If cement or other plugs were used, state the character of same and depth placed, from \_\_\_\_\_ feet to \_\_\_\_\_ feet for each plug set.

Filled hole with mud to 190 ft. Set  
plug at 190' with 20 sx. cement. Mud  
to 35 ft., set plug at 35 ft. with 10 sx.  
cement. Mud to surface

(If additional description is necessary, use BACK of this sheet)

Name of Plugging Contractor Messman-Rinehart Oil Company  
Address 518 Petroleum Bldg., Wichita, Kansas

STATE OF Kansas, COUNTY OF Sedgwick, ss.  
J. A. Gilliland (employee of owner) or operator of the above-described well, being first duly sworn on oath, says: That I have knowledge of the facts, statements, and matters herein contained and the log of the above-described well as filed and that the same are true and correct. So help me God.

(Signature) J. A. Gilliland  
518 Petroleum Bldg., Wichita, Kansas  
(Address)

SUBSCRIBED AND SWORN to before me this 14th day of November, 19 58

My commission expires December 1, 1960

Barbara J. Scott  
Barbara J. Scott, Notary Public.

RECEIVED  
CORPORATION COMMISSION  
12-4-1958  
DEC 4 - 1958

PLUGGING  
FILE SEC. 14 Twp. 29S R. 11W  
BOOK PAGE 149 LINE 11

CONSERVATION DIVISION  
Wichita, Kansas

NO. 1 HISKETT

Well Record

<b>Location:</b>	NE/4 NE/4 NW/4 Section 14-29S-11W Pratt County, Kansas	<b>Commenced:</b>	October 22, 1958
<b>Operator:</b>	Messman-Rinehart Oil Company 518 Petroleum Building Wichita, Kansas	<b>Completed:</b>	November 7, 1958
<b>Contractor:</b>	Messman-Rinehart Oil Company 518 Petroleum Building Wichita, Kansas	<b>Elevation:</b>	1782 K/B
		<b>Production:</b>	D & A

Casing Record: 10-3/4" @ 196' w/160 sx. cem., 3 gal, 3 c.c.

\* \* \* L O G \* \* \*

Clay & Sand	122
Red Bed	700
Shale & Shells	1200
Shale & Shells	1412
Shale & Shells with streaks of Anhydrite	1475
Anhydrite	1670
Lime & Shale	2660
Shale & Lime	2885
Lime & Shale	3380
Shale, Sand & Lime	3535
Lime & Shale	3780
Lime	3825
Lime & Chert	3875
Lime	4045
Lime & Shale	4203
Lime	4268
Lime & Shale	4277
Lime & Chert	4295
Chert & Lime	4325
Lime	4335
Shale	4508
Lime & Chert	4595
Sand & Shale	4620
Shale & Sand	4650
Lime	4705
Arbuckle	4710 R.T.D.

Sample Tops:

3748'	- Lansing (-1966)
4277'	- Miss. "Chat" (-2495)
4318'	- Miss. Lime (-2536)
4334'	- Kinderhook (-2552)
4508'	- Viola (-2726)
4582'	- Simpson Shale (-2800)
4605'	- Simpson Sand (-2823)
4670'	- Arbuckle (-2888)

The undersigned, MESSMAN-RINEHART OIL COMPANY, hereby certifies that the above log is a true and correct log of the formation encountered in drilling the above well as reflected by the Daily Drilling Reports.

MESSMAN-RINEHART OIL COMPANY

By: \_\_\_\_\_

*J. A. Gilliland*  
J. A. Gilliland

Subscribed and sworn to before me  
this 14th day of November, 1958.

*Barbara J. Scott*  
Barbara J. Scott, Notary Public

**RECEIVED**  
STATE CORPORATION COMMISSION

My Commission Expires: December 1, 1960

DEC 4 - 1958

<b>PLUGGING</b>
FILE SEC. 14 T. 29 R. 11W
BOOK PAGE 149 LINE 11

CONSERVATION DIVISION  
Wichita, Kansas