


STATE OF KANSAS  
STATE CORPORATION COMMISSION

Give All Information Completely  
Make Required Affidavit  
Mail or Deliver Report to:  
Conservation Division  
State Corporation Commission  
212 North Market, Insurance Bldg.  
Wichita, Kansas

WELL PLUGGING RECORD

Pratt County. Sec. 11 Twp. 29 Rge. 11 (E) (W)  
Location as "NE/CNW/SW" or footage from lines C NW SW  
Lease Owner Murxxx Kern Drilling Company  
Lease Name Murry Well No. 1  
Office Address Box 107 Liberal, Kansas  
Character of Well (completed as Oil, Gas or Dry Hole) Dry hole  
Date well completed 7-18-61 19  
Application for plugging filed 7-18-61 19  
Application for plugging approved 7-18-61 19  
Plugging commenced 7-18-61 19  
Plugging completed 7-18-61 19  
Reason for abandonment of well or producing formation dry hole

NORTH

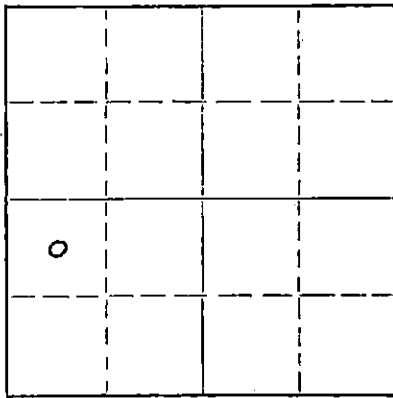

Locate well correctly on above Section Plat

If a producing well is abandoned, date of last production \_\_\_\_\_ 19\_\_\_\_  
Was permission obtained from the Conservation Division or its agents before plugging was commenced? yes

Name of Conservation Agent who supervised plugging of this well Fred Hampel  
Producing formation none Depth to top \_\_\_\_\_ Bottom \_\_\_\_\_ Total Depth of Well \_\_\_\_\_ Feet  
Show depth and thickness of all water, oil and gas formations.

OIL, GAS OR WATER RECORDS

CASING RECORD

FORMATION	CONTENT	FROM	TO	SIZE	PUT IN	PULLED OUT

Describe in detail the manner in which the well was plugged, indicating where the mud fluid was placed and the method or methods used in introducing it into the hole. If cement or other plugs were used, state the character of same and depth placed, from \_\_\_\_\_ feet to \_\_\_\_\_ feet for each plug set.

Cement plug of 25 sacks at 190'  
Cement plug of 15 sacks at 35'  
cement plug of 5 sacks in rat hole

RECEIVED  
STATE CORPORATION COMMISSION  
JUL 31 1961  
CONSERVATION DIVISION  
Wichita Kansas

(If additional description is necessary, use BACK of this sheet)  
Name of Plugging Contractor Sun Oil Well Cementing Inc.  
Address ~~Kernxxx~~ Great Bend, Kansas

STATE OF Kansas, COUNTY OF Seward, ss.  
\_\_\_\_\_  
(employee of owner) or (owner or operator) of the above-described well, being first duly sworn on oath, says: That I have knowledge of the facts, statements, and matters herein contained and the log of the above-described well as filed and that the same are true and correct. So help me God.

(Signature) Lanuth L. Mayhew

SUBSCRIBED AND SWORN to before me this 27 day of July, 1961  
Edw. M. Hart  
(Address)

My commission expires 12-18-62 Notary Public.