


STATE OF KANSAS
STATE CORPORATION COMMISSION
CONSERVATION DIVISION
P. O. BOX 17027
WICHITA, KANSAS 67217

FORM CP-4

WELL PLUGGING RECORD

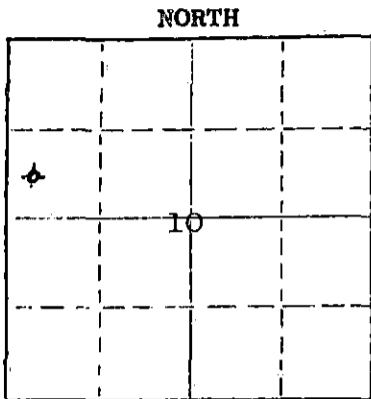

Locate well correctly on above
Section Plot

Pratt County, Sec. 10 Twp. 29S Rge. 11W (W)
Location as "NE/CNW/SE/SW" or footage from lines Approx. 150' W of C SW NW
Lease Owner Kansas Petroleum, Inc.
Lease Name Hirt Well No. 1
Office Address 500 Insurance Bldg., Wichita, Kansas 67202
Character of Well (completed as Oil, Gas or Dry Hole) Dry Hole
Date well completed April 15, 1978
Application for plugging filed April 15, 1978
Application for plugging approved April 15, 1978
Plugging commenced April 15, 1978
Plugging completed April 15, 1978
Reason for abandonment of well or producing formation Dry Hole

If a producing well is abandoned, date of last production 19
Was permission obtained from the Conservation Division or its agents before plugging was commenced? Yes

Name of Conservation Agent who supervised plugging of this well _____
Producing formation _____ Depth to top _____ Bottom _____ Total Depth of Well 2705 feet
Show depth and thickness of all water, oil and gas formations.

OIL, GAS OR WATER RECORDS

CASING RECORD

FORMATION	CONTENT	FROM	TO	SIZE	PUT IN	PULLED OUT
		0'	300'	8-5/8"	292.35'	None

RECEIVED
STATE CORPORATION COMMISSION
APR 25 1978
CONSERVATION DIV. S. D.
Wichita, Kansas

Describe in detail the manner in which the well was plugged, indicating where the mud fluid was placed and the method or methods used in introducing it into the hole. If cement or other plugs were used, state the character of same and depth placed, from _____ feet to _____ feet for each plug set.

Plugged with 40 sacks cement at 540',
35 sacks cement at 300', 12 sacks cement
and plug at 40', 3 sacks cement in rat hole.

(If additional description is necessary, use BACK of this sheet)

Name of Plugging Contractor Halliburton Cementing Co.
Address 410 Union Center, Wichita, Kansas 67202

STATE OF KANSAS, COUNTY OF SEDGWICK, ss.
John D. Knightley, Agent (employee of owner) or (owner or operator) of the above-described

well, being first duly sworn on oath, says: That I have knowledge of the facts, statements, and matters herein contained and the log of the above-described well as filed and that the same are true and correct. So help me God.

(Signature) [Signature]
221 S. Broadway, Wichita, Kansas
(Address)

SUBSCRIBED AND SWORN to before me this 24th day of April, 1978

My commission expires March 12, 1979
[Signature] Notary Public.

Kansas Petroleum, Inc. - Hirt #1
Approx. 150' W of C SW NW
Sec. 10-29S-11W
Pratt County, Kansas

Contractor: D. R. Lauck Oil Company, Inc.
221 S. Broadway, Suite 400
Wichita, Kansas 67202

Commenced: April 12, 1978
Completed: April 15, 1978

Drillers Log

Clay	70
Sand	135
Red Bed	305
Red Bed & Shale	1105
Shale & Shells	2270
Shale & Lime	2490
Shale & Shells	2672
Shale & Lime	2705 RTD

RECEIVED
STATE CORPORATION COMMISSION

APR 25 1978

CONSERVATION DIVISION
Wichita, Kansas