


STATE OF KANSAS
STATE CORPORATION COMMISSION

WELL PLUGGING RECORD

Give All Information Completely
Make Required Affidavit
Mail or Deliver Report to
Conservation Division
State Corporation Comm.
245 North Water
Wichita, KS 67202

Pratt County, Sec. 3 Twp. 29S Rge. 11W E/W
Location as "NE/CNW 1/4 SW 1/4" or footage from lines
C N/2 NW SE

Lease Owner Associated Petroleum Consultants, Inc.
Lease Name Rutherford Well No. #2
Office Address Suite 600 - One Main Place, Wichita, KS
Character of Well (Completed as Oil, Gas or Dry Hole)
Dry Hole

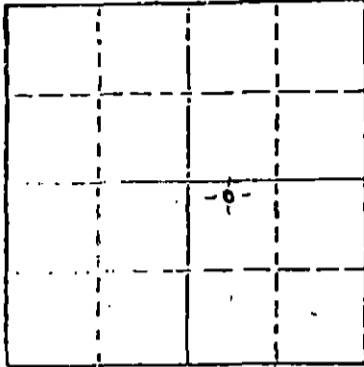

Locate well correctly on above
Section Plat

Date Well completed May 6, 19 82
Application for plugging filed May 6, 19 82
Application for plugging approved May 6, 19 82
Plugging commenced 1:00 p.m. 19
Plugging completed 2:45 p.m. 19

Reason for abandonment of well or producing formation
D & A
If a producing well is abandoned, date of last production
none 19

Was permission obtained from the Conservation Division of
its agents before plugging was commenced? yes

Name of Conservation Agent who supervised plugging of this well Maurice Leslie
Producing formation X Depth to top X Bottom X Total Depth of Well 2730'
Show depth and thickness of all water, oil and gas formations.

OIL, GAS OR WATER RECORDS

CASING RECORD

FORMATION	CONTENT	FROM	TO	SIZE	PUT IN	PULLED OUT
				8 5/8"	410'	none

Describe in detail the manner in which the well was plugged, indicating where the mud fluid was placed and the method or methods used in introducing it into the hold. If cement or other plugs were used, state the character of same and depth placed, from _____ feet to _____ feet for each plug set.

- Ran 60 sacks @ 750'
- 40 sacks @ 400'
- 10 sacks @ 40' with wooden plug & 1/2 sack hulls
- 10 sacks Rat Hole
- 5 sacks Mouse Hole
- 3 sacks water well
- Common cement with 3% CaCl 2% gel

(If additional description is necessary, use BACK of this sheet)

Name of Plugging Contractor Heartland Drilling, Inc.


STATE OF KANSAS COUNTY OF SEDGWICK, ss.
Phyllis Buchanan (employee of owner) or (owner or operator)
of the above-described well, being first duly sworn on oath, says: That I have knowledge of the facts, statements, and matters herein contained and the log of the above-described well as filed and that the same are true and correct. So help me God.

(Signature) Phyllis Buchanan
PHYLLIS BUCHANAN
(Address)

SUBSCRIBED AND SWORN TO before me this 10th day of May, 1982

My commission expires

Sherry Wayman
SHERRY WAYMAN Notary Public.
STATE CORPORATION COMMISSION

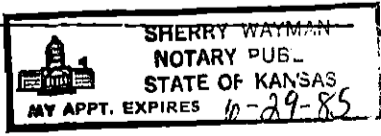

MAY 17 1982
05-17-82
CONSERVATION DIVISION
Wichita, Kansas