



# WELL LOG

Operator Midco Drilling, Inc.  
 Comm \_\_\_\_\_ Comp \_\_\_\_\_  
 Shot \_\_\_\_\_ Qts. From \_\_\_\_\_ ft. To \_\_\_\_\_ ft.  
 Acidized \_\_\_\_\_ Gal. \_\_\_\_\_  
 Prod. Formation \_\_\_\_\_  
 Initial Prod. \_\_\_\_\_  
 Elevation \_\_\_\_\_

Lease Posey Well No. 1  
 Loc 75 E of Sec \_\_\_\_\_ Twp \_\_\_\_\_ Rge \_\_\_\_\_  
 County SE SW SW Sedgwick State Kansas  
 Contractor Triangle Drlg & Expl Co., Inc.  
 Casing Record

Size	Ft.	Pulled	Remarks
8 5/8	460	415	sks cement

## FIGURES INDICATE BOTTOM OF FORMATION

0	-----	460	Surface
460	-----	490	Shale & Shells
490	-----	709	Shale & Lime
709	-----	1555	Shale & Lime
1555	-----	2315	Lime & Shale
2315	-----	2910	Shale & Lime
2910	-----	3054	Shale & Lime
3054	-----	3117	Lansing
3117	-----	3125	Shale
3125	-----	3195	K.C.
3195	-----	3289	Lime & Shale
3289	-----	3430	Lime
3430	-----	3551	Conglomerate
3551	-----	3570	Chert
3570	-----	3580	Mississippi RTD

RECEIVED  
 STATE CORPORATION COMMISSION  
 JUN 22 1961  
 CONSERVATION DIVISION  
 Wichita, Kansas

KANSAS

WELL COMPLETION REPORT AND  
DRILLER'S LOGAPI No. 15 — Sedgwick — 173-20,393  
County Number

Operator

Midco Drilling, Inc.

Address

200 East First, Suite 520, Wichita, Ks. 67202

Well No.

1

Lease Name

Posey

Footage Location

660

feet from (X) (S) line

660

feet from (X) (W) line

Principal Contractor

Triangle Drilling, Inc.

Geologist

J. Corry Tinsmon

Spud Date

6/2/81

Date Completed

6/14/81

Total Depth

3580'

P.B.T.D.

Directional Deviation

up to 16½°

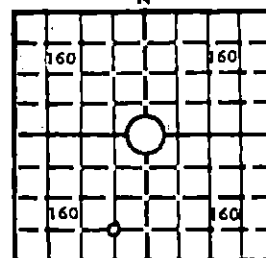
Oil and/or Gas Purchaser

D &amp; A (crooked hole)

S. 35 T. 27 R. 2 NE W

Loc. 75' E of C SE SW

County Sedgwick

640 Acres  
N

Locate well correctly

Elev.: Gr. 1380

DF. KB. 1385

## CASING RECORD

Report of all strings set — surface, intermediate, production, etc.

Purpose of string	Size hole drilled	Size casing set (in O.D.)	Weight lbs/ft.	Setting depth	Type cement	Sacks	Type and percent additives
Surface	12½	8.5/8		460'	Common Pozmix	100 250	

## LINER RECORD

## PERFORATION RECORD

Top, ft.	Bottom, ft.	Sacks cement	Shots per ft.	Size & type	Depth interval

## TUBING RECORD

Size	Setting depth	Packer set at

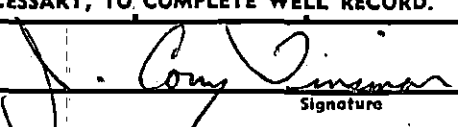
## ACID, FRACTURE, SHOT, CEMENT SQUEEZE RECORD

Amount and kind of material used	Depth interval treated

## INITIAL PRODUCTION

Date of first production		Producing method (flowing, pumping, gas lift, etc.)				OIL & GAS PRODUCTION REPORT RECEIVED	
RATE OF PRODUCTION PER 24 HOURS		Oil	Gas	Water	Gas-oil ratio		
		bbls.	MCF	bbls.	CFPB		
Disposition of gas (vented, used on lease or sold)				Producing interval (s)			

INSTRUCTIONS: As provided in KCC Rule 82-2-125, within 90 days after completion of a well, one completed copy of this Drillers Log shall be transmitted to the State Geological Survey of Kansas, 4150 Monroe Street, Wichita, Kansas 67209. Copies of this form are available from the Conservation Division, State Corporation Commission, 245 No. Water, Wichita, Kansas 67202. Phone AC 316-522-2206. If confidential custody is desired, please note Rule 82-2-125. Drillers Logs will be on open file in the Oil and Gas Division, State Geological Survey of Kansas, Lawrence, Kansas 66044.

Operator <b>Midco Drilling, Inc.</b>		DESIGNATE TYPE OF COMP.: OIL, GAS, DRY HOLE, SWDW, ETC.: <b>D &amp; A (crooked hole)</b>									
Well No. <b>1.</b>	Lease Name <b>Posey</b>										
<b>S 35 T27 R 2 <math>\frac{1}{2}</math> W</b>											
<b>WELL LOG</b>		SHOW GEOLOGICAL MARKERS, LOGS RUN, OR OTHER DESCRIPTIVE INFORMATION.									
Show all important zones of porosity and contents thereof; cored intervals, and all drill-stem tests, including depth interval tested, cushion used, time tool open, flowing and shut-in pressures, and recoveries.											
FORMATION DESCRIPTION, CONTENTS, ETC.	TOP	BOTTOM	NAME								
<div style="text-align: center;"><u>SAMPLE TOPS</u></div> <table style="width: 100%; border-collapse: collapse;"> <tr> <td style="width: 40%;">Iatan</td> <td style="width: 60%;">2613 (-1228)</td> </tr> <tr> <td>Kansas City</td> <td>2948 (-1563)</td> </tr> <tr> <td>BKC</td> <td>3139 (-1754)</td> </tr> <tr> <td>Mississippi</td> <td>3550 (-2165)</td> </tr> </table> <p style="margin-top: 20px; text-align: center;"> <i>Mis Run</i>  ALL DRILL STEM TESTS WERE <del>MISS</del> RUN </p>				Iatan	2613 (-1228)	Kansas City	2948 (-1563)	BKC	3139 (-1754)	Mississippi	3550 (-2165)
Iatan	2613 (-1228)										
Kansas City	2948 (-1563)										
BKC	3139 (-1754)										
Mississippi	3550 (-2165)										
<div style="float: left; width: 30%; text-align: right;"> <b>RECEIVED</b>          Date <b>6/19/81</b> </div> <div style="float: right; width: 70%;">         USE ADDITIONAL SHEETS, IF NECESSARY, TO COMPLETE WELL RECORD. </div> <div style="clear: both;"></div>											
RECEIVED Date <b>6/19/81</b>		<div style="text-align: center;">   <b>Geologist</b>  <b>6/19/81</b>          Signature          Title          Date </div>									