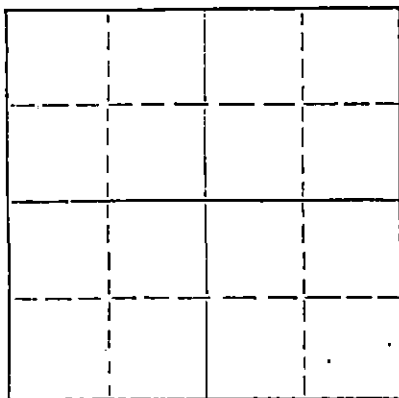


STATE OF KANSAS
STATE CORPORATION COMMISSION

Give All Information Completely
Make Required Affidavit
Mail or Deliver Report to:
Conservation Division
State Corporation Commission
211 No. Broadway
Wichita, Kansas

WELL PLUGGING RECORD

NORTH

Locate well correctly on above
Section Plat

Sedgwick

County. Sec. 4 Twp. 27S Rge. 2 (E) W (W)

Location as "NE/CNW/SW" or footage from lines SW-SE-SE

Lease Owner, I Adair Oil Company

Lease Name Betzen

Well No. 1

Office Address Box 7011, Wichita, Kansas

Character of Well (completed as Oil, Gas or Dry Hole) Dry Hole

Date well completed 7-3-65 19

Application for plugging filed 7-3-65 19

Application for plugging approved 7-3-65 19

Plugging commenced 7-3-65 19

Plugging completed 7-3-65 19

Reason for abandonment of well or producing formation

If a producing well is abandoned, date of last production 19

Was permission obtained from the Conservation Division or its agents before plugging was commenced? Yes

Name of Conservation Agent who supervised plugging of this well Paul Trupin

Producing formation Depth to top Bottom Total Depth of Well 1275' Feet

Show depth and thickness of all water, oil and gas formations.

OIL, GAS OR WATER RECORDS

CASING RECORD

FORMATION	CONTENT	FROM	TO	SIZE	PUT IN	PULLED OUT
				8-5/8"	274'	None

Describe in detail the manner in which the well was plugged, indicating where the mud fluid was placed and the method or methods used in introducing it into the hole. If cement or other plugs were used, state the character of same and depth placed, from feet to feet for each plug set.

Mud up to 215' set plug - added 5' of rocks. Mixed and dumped 5 sxs cement thru pipe, then added 20 sxs cement, mud up to 30'. Set plug and add 8 sxs cement. Put 2 in rat hole.

RECEIVED
STATE CORPORATION COMMISSION

JUL 23 1965

CONSERVATION DIVISION
Wichita, Kansas

(If additional description is necessary, use BACK of this sheet)

Name of Plugging Contractor Glickman Oil Company

Address Box 3104, Wichita, Kansas

STATE OF Kansas, COUNTY OF Sedgwick, ss.

Milton Glickman (employee of owner) or (owner or operator) of the above-described well, being first duly sworn on oath, says: That I have knowledge of the facts, statements, and matters herein contained and the log of the above-described well as filed and that the same are true and correct. So help me God.

(Signature)

Milton Glickman
Box 3104, Wichita, Kansas

(Address)

SUBSCRIBED AND SWORN to before me this 20th day of July, 1965

My commission expires November 19, 1967

Lorella Schauf

Notary Public.

GLICKMAN OIL COMPANY

P.O. Box 3104

Wichita, Kansas 67211

DRILLERS WELL LOG

Company: Adair Oil Company

Location: SW-SE-SE

4-27S-2W

Farm: Betzen

Well No. 1

Sedgwick County, Kansas

Commenced: 6-30-65

Elevation:

Completed: 7-3-65

Total Depth: 1275

Geologist: Sherrill Compton

Casing: 8-5/8" @ 274 w/ 185 sxs

Production: D & A

Figures Indicate Bottom of Formations

50' Clay & Sand
808' Shale & Shells
1275' Lime & Shale
1275' T.D.

Lost hole - skidded rig 25' east to Betzen #1-A

RECEIVED
STATE CORPORATION COMMISSION

JUL 23 1965

CONSERVATION DIVISION
Wichita, Kansas

STATE OF KANSAS, COUNTY OF SEDGWICK, ss:

I, Milton Glickman, of the Glickman Oil Company, upon oath state that the above and foregoing is a true and correct copy of the log of the Betzen #1

Milton Glickman

Subscribed and sworn to before me this 20th day of July, 1965

Lorella Schauf
Lorella Schauf

Notary Public

My Commission Expires: November 19, 1967