

CONFIDENTIAL
CONFIDENTIAL

SIDE ONE

STATE CORPORATION COMMISSION OF KANSAS
OIL & GAS CONSERVATION DIVISION
WELL COMPLETION FORM
ACO-1 WELL HISTORY
DESCRIPTION OF WELL AND LEASE

Operator: License # 5447

Name: OXY USA Inc.

Address P. O. Box 26100

Oklahoma City, OK 73126-0100

City/State/Zip _____

Purchaser: CIG

Operator Contact Person: Raymond Hui

Phone (405) 749-2471

Contractor: Name: Exeter Drilling Company

Licenses: 3098

Wellsite Geologist: Craig Corbett

Designate Type of Completion

New Well Re-Entry Workover

Oil SWD Temp. Abd.

Gas Inj Delayed Comp.

Dry Other (Core, Water Supply, etc.)

If OWO: old well info as follows:

Operator: _____

Well Name: _____

Comp. Date _____ Old Total Depth _____

Drilling Method:

Mud Rotary Air Rotary Cable

7-6-90 7-9-90 7-25-90

Spud Date Date Reached TD Completion Date

API NO. 15- 081-20629-0000

County Haskell

approx. NW SE SE/4 Sec. 5 Twp. 29S Rge. 34 East West

1250 Ft. North from Southeast Corner of Section

1250 Ft. West from Southeast Corner of Section
(NOTE: Locate well in section plat below.)


Lease Name Hall K Well # 10

Field Name Kansas Hugoton Gas

Producing Formation Chase

Elevation: Ground 3005' KB 3015'

Total Depth 3068' PBD 3032'

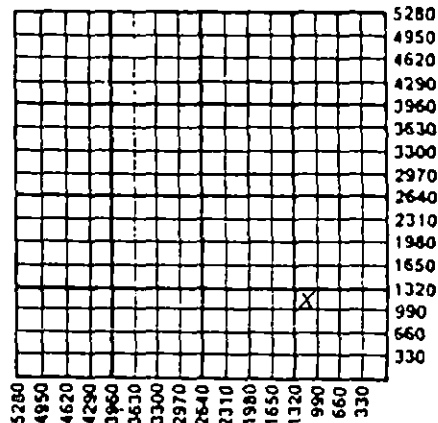

Amount of Surface Pipe Set and Cemented at 817' Feet

Multiple Stage Cementing Collar Used? Yes No

If yes, show depth set _____ Feet

If Alternate II completion, cement circulated from _____

feet depth to _____ w/ _____ sx cmt.

INSTRUCTIONS: This form shall be completed in triplicate and filed with the Kansas Corporation Commission, 200 Colorado Derby Building, Wichita, Kansas 67202, within 120 days of the spud date of any well. Rule 82-3-130, 82-3-107 and 82-3-106 apply. Information on side two of this form will be held confidential for a period of 12 months if requested in writing and submitted with the form. See rule 82-3-107 for confidentiality in excess of 12 months. One copy of all wireline logs and drillers time log shall be attached with this form. ALL CEMENTING TICKETS MUST BE ATTACHED. Submit CP-4 form with all plugged wells. Submit CP-111 form with all temporarily abandoned wells. Any recompletion, workover or conversion of a well requires filing of ACO-2 within 120 days from commencement date of such work.

All requirements of the statutes, rules and regulations promulgated to regulate the oil and gas industry have been fully complied with and the statements herein are complete and correct to the best of my knowledge.

Signature Vic Tumlinson John M. White

Title Operations Drilling Manager Date 9-17-90

Subscribed and sworn to before me this 17th day of September, 19 90.

Notary Public Deborah Kay Mattis

Date Commission Expires 3/24/94

K.C.C. OFFICE USE ONLY

F Letter of Confidentiality Attached

C Wireline Log Received

C Drillers Timelog Received

Distribution

KCC SWD/Rep NGPA

KGS Plug Other

Oil Gas Inc (Specify)