


STATE OF KANSAS
STATE CORPORATION COMMISSION

Give All Information Completely
Make Required Affidavit
Mail or Deliver Report to:
Conservation Division
State Corporation Commission
211 No. Broadway
Wichita, Kansas

WELL PLUGGING RECORD

Pratt County, Sec. 22 Twp. 29S Rge. 13W (E) (W)
Location as "NE/CNW/SW" or footage from lines C NW SE
Lease Owner Kern-Landes Expl. Co. Inc.
Lease Name Pitzer Well No. 1
Office Address Box 107, Liberal, Kansas
Character of Well (completed as Oil, Gas or Dry Hole) Dry Hole
Date well completed August 2 19 64
Application for plugging filed August 2 19 64
Application for plugging approved August 2 19 64
Plugging commenced August 2 19 64
Plugging completed August 2 19 64
Reason for abandonment of well or producing formation Dry Hole

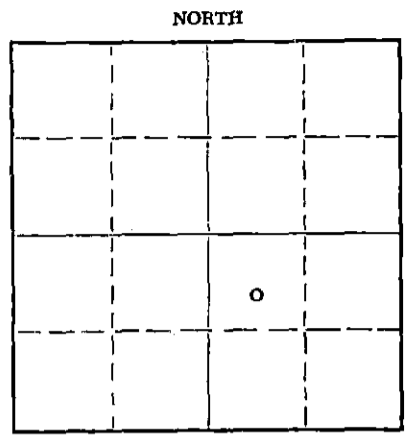

Locate well correctly on above Section Plat

If a producing well is abandoned, date of last production _____ 19____
Was permission obtained from the Conservation Division or its agents before plugging was commenced? Yes

Name of Conservation Agent who supervised plugging of this well Archie V. Elving, Pratt, Kansas
Producing formation _____ Depth to top _____ Bottom _____ Total Depth of Well 4725 Feet
Show depth and thickness of all water, oil and gas formations.

OIL, GAS OR WATER RECORDS

CASING RECORD

FORMATION	CONTENT	FROM	TO	SIZE	PUT IN	PULLED OUT
		0	303'	10 3/4"	303'	None

Describe in detail the manner in which the well was plugged, indicating where the mud fluid was placed and the method or methods used in introducing it into the hole. If cement or other plugs were used, state the character of same and depth placed, from _____ feet to _____ feet for each plug set.

Set Plug @ 200'/20 sacks cement
40'/15 sacks cement

RECEIVED
STATE CORPORATION COMMISSION
AUG 17 1964
CONSERVATION DIVISION
Wichita, Kansas

(If additional description is necessary, use BACK of this sheet)
Name of Plugging Contractor Hellar Drilling Company, Inc.
Address 1014 Union Center, Wichita, Kansas 67202

STATE OF Kansas, COUNTY OF Sedgwick, ss.
D. L. Hellar, Pres. of Hellar Drlg. Co. Inc. (employee of owner) or (owner or operator) of the above-described well, being first duly sworn on oath, says: That I have knowledge of the facts, statements, and matters herein contained and the log of the above-described well as filed and that the same are true and correct. So help me God.

(Signature) D. L. Hellar D. L. Hellar, Pres.
1014 Union Center, Wichita, Kansas 67202
(Address)

SUBSCRIBED AND SWORN TO before me this 14th day of August, 19 64

My commission expires March 25, 1968.
Catherine Darcey Notary Public.

DRILLER'S LOG

COMPANY: Kern-Landes Expl. Co., Inc.
 CONTRACTOR: Hellar Drilling Company, Inc.
 LEASE: #1 Pitzer
 LOCATION: C NW SE 22-29S-13W, Pratt County, Kansas
 COMMENCED: July 17, 1964
 COMPLETED: August 2, 1964
 CASING: Set 10 3/4" surface casing @ 303' / 300' sacks cement

0-265	Sand & gravel
265-303	Red Bed & Shale
303-717	Shale & Sand
717-722	Anhydrite
722-959	Sand - Shale
959-1660	Shale-Shells & Salt Section
1660-1760	Salt Section
1760-2030	Salt Section & Shale & Shells
2030-2190	Salt Section & Ft. Riley Lime
2190-2818	Lime & Shale
2818-2980	Shale & Lime
2980-3078	Shale & Lime & Sandy Sh.
3078-3526	Lime & Shale
3526-3776	Shale & Lime
3776-3957	Lime & Shale
3957-4049	Lime (K.C.)
4049-4116	Lsg. K.C.
4116-4185	Lime K.C.
4185-4217	Lime
4217-4265	Lime-Shaley Lime
4265-4305	Lime
4305-4361	Lime w/Shale Stks.
4361-4409	Lime-Bk. Lime & Shale
4409-4488	Kinderhook
4488-4524	Lime
4524-4563	Viola Section
4563-4590	Viola
4590-4599	#1 Core
4599-4614	Simpson
4614-4680	Shale & Lime & some chert
4680-4710	Shale & Arbuckle
4710-4725	Arbuckle
4725	Rotary Total Depth
	Dry and Abandoned

RECEIVED
 STATE CORPORATION COMMISSION
 AUG 17 1964
 CONSERVATION DIVISION
 Wichita, Kansas

STATE OF KANSAS)
) SS
 COUNTY OF SEDGWICK)

I, D. L. Hellar, do hereby certify that the above and foregoing is a true and correct copy of the log of the #1 Pitzer located in C NW SE 22-29S-13W, Pratt County, Kansas, as reflected by the files of the Hellar Drilling Company, Inc.

HELLAR DRILLING COMPANY, INC.
 By D. L. Hellar
 President - D. L. Hellar

Subscribed and sworn to before me, a Notary Public, in and for Sedgwick County, Kansas, this 14th day of August, 1964.

My Commission Expires:
 March 25, 1968.

Catherine Dargatzis
 Notary Public - Catherine Dargatzis