


STATE OF KANSAS  
STATE CORPORATION COMMISSION

Give All Information Completely  
Make Required Affidavit  
Mail or Deliver Report to:  
Conservation Division  
State Corporation Commission  
800 Bitting Building  
Wichita, Kansas

WELL PLUGGING RECORD

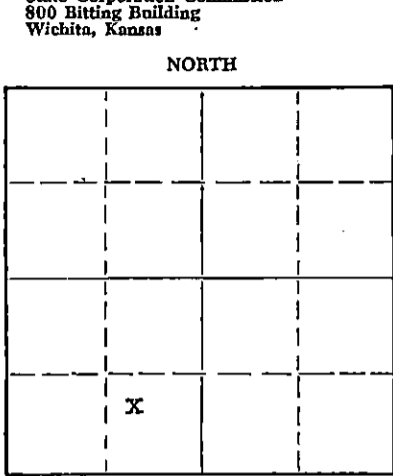

Pratt County, Sec. 22 Twp. 29S Rge. 13 #/ (W)  
Location as "NE/CNW/SW" or footage from lines C-NW/4 SE/4 SW/4  
Lease Owner Lion Oil Company  
Lease Name Barnhart Well No. 1  
Office Address P. O. Box 639, Pratt, Kansas  
Character of Well (completed as Oil, Gas or Dry Hole) Dry Hole  
Date well completed September 18, 19 55  
Application for plugging filed September 18, 19 55  
Application for plugging approved (Verbal) September 18, 19 55  
Plugging commenced September 18, 19 55  
Plugging completed September 18, 19 55  
Reason for abandonment of well or producing formation Dry Hole

If a producing well is abandoned, date of last production 19  
Was permission obtained from the Conservation Division or its agents before plugging was commenced? Yes

Name of Conservation Agent who supervised plugging of this well Mr. M. A. Rives  
Producing formation Depth to top Bottom Total Depth of Well 4768' Feet  
Show depth and thickness of all water, oil and gas formations.

OIL, GAS OR WATER RECORDS

CASING RECORD

FORMATION	CONTENT	FROM	TO	SIZE	PUT IN	PULLED OUT
				8-5/8"	380'	None

Describe in detail the manner in which the well was plugged, indicating where the mud fluid was placed and the method or methods used in introducing it into the hole. If cement or other plugs were used, state the character of same and depth placed, from feet to feet for each plug set.  
Heavy mud from 4765' to 300'. Bottom plug set @ 300' with 20 sacks of cement.  
Heavy mud from 300' to 30' with plug @ 30' and 10 sacks of cement on top of plug.

(If additional description is necessary, use BACK of this sheet)

Name of Plugging Contractor Garvey Drilling Company  
Address 305 East 2nd St., Wichita, Kansas

STATE OF KANSAS, COUNTY OF PRATT, ss.  
J. B. Gibbs (employee of owner) or (owner/operator) of the above-described well, being first duly sworn on oath, says: That I have knowledge of the facts, statements, and matters herein contained and the log of the above-described well as filed and that the same are true and correct. So help me God.

(Signature) [Signature] P. O. Box 639, Pratt, Kansas (Address)

SUBSCRIBED AND SWORN to before me this 19th day of September 19 55

My commission expires 12-2-57

RECEIVED STATE CORPORATION COMMISSION Notary Public.

PLUGGING FILE SEC-22 T-29 R-136 BOOK PAGE 2 LINE 2

SEP 23 1955 09-23-55 CONSERVATION DIVISION Wichita, Kansas

# WELL LOG

COMPANY LION OIL COMPANY

SEC. 22 T. 29S R. 13W

FARM Barnhart

NO. #1

LOC. NE SE SW

TOTAL DEPTH 4765'

COUNTY Pratt

COMM. September 2, 1955 COMP. September 19, 1955

CONTRACTOR GARVEY DRILLING COMPANY

CASING 8 5/8" @ 380'



ELEVATION Unknown

PRODUCTION Unknown

FIGURES INDICATE BOTTOM OF FORMATIONS

380	Red Bed & Shale
465	Red Rock
540	Sand
630	Red Rock
720	Shale & Sand
740	Anhydrite
975	Shale and salt
1530	Shale & Red Bed
1930	Shale
2020	Shale, Lime & Shells
2220	Lime & Shale
2310	Lime
2670	Lime & Shale
3060	Shale
3145	Shale & Lime
3210	Shale
3560	Shale & Lime
3745	Lime
3950	Lime & Shale
4441	Lime
4517	Lime & Shale
4622	Lime
4655	Sand & Shale
4694	Sand & Shale
4714	Lime & Shale
4765	Lime
4765	T. D.

RECEIVED  
STATE CORPORATION COMMISSION  
OCT 1 1955

CONSERVATION DIVISION  
Wichita, Kansas

State of KANSAS  
County of SEDGWICK

PLUGGING  
SEC 22 T 29 R 13 W  
PAGE 2 LINE 2

I, Eric H. Jager of GARVEY DRILLING COMPANY

upon oath state that the above and foregoing is a true and correct copy of the log of the #1 Barnhart well

Subscribed and sworn to before me this 26th day of September 19 55

My Commission Expires: August 8, 1959

Gloria Morrison  
NOTARY PUBLIC