


STATE OF KANSAS
STATE CORPORATION COMMISSION

Form CP-4

Give All Information Completely
Make Required Affidavit
Mail or Deliver Report to:
Conservation Division
State Corporation Commission
P. O. Box 17027

WELL PLUGGING RECORD

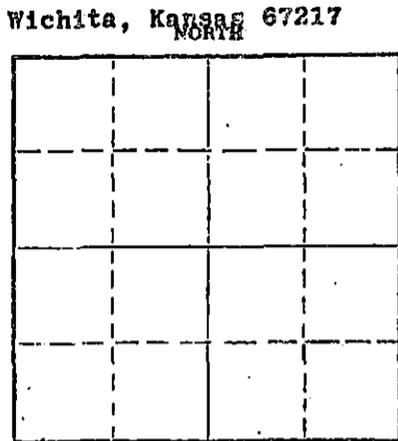

Locate well correctly on above
Section Plat

Pratt County, Sec. 22 Twp. 29 Rge. 13 (E) (W)
Location as "NE/CNWKSWK" or footage from lines NE NE
Lease Owner Rains & Williamson Oil Co.
Lease Name Lee #1 Well No.
Office Address Wichita, Kansas 67202
Character of Well (completed as Oil, Gas or Dry Hole)
Date well completed 19
Application for plugging filed 19
Application for plugging approved 19
Plugging commenced 3/22/73 19
Plugging completed 4/2/73 19
Reason for abandonment of well or producing formation depleted.

If a producing well is abandoned, date of last production 19
Was permission obtained from the Conservation Division or its agents before plugging was commenced? yes

Name of Conservation Agent who supervised plugging of this well Biberstein
Producing formation Depth to top Bottom Total Depth of Well 4669 Feet
Show depth and thickness of all water, oil and gas formations.

OIL, GAS OR WATER RECORDS

CASING RECORD

FORMATION	CONTENT	FROM	TO	SIZE	PUT IN	PULLED OUT
				13"	281	none
				5 1/2"	4669	3020'

Describe in detail the manner in which the well was plugged, indicating where the mud fluid was placed and the method or methods used in introducing it into the hole. If cement or other plugs were used, state the character of same and depth placed, from feet to feet for each plug set.

2 Checked hole, pushed plug to 4500' and dumped 5 sacks cement.
Loaded hole, shot pipe at 3500', 3310', 3118', 3022', worked
pipe loose and pulled 76 joints. Circulated mud and hulls,
pulled pipe to 280' and circulated 150 sacks cement to base of
cellar. Ran 5 sacks of cement on top.

PLUGGING COMPLETE.

RECEIVED
STATE CORPORATION COMMISSION

APR 9 1973

CONSERVATION DIVISION
Wichita, Kansas

Name of Plugging Contractor ~~XXXXXXXXXXXXXXXXXXXXXXXXXXXXXXXXXXXX~~ KELSO CASING PULLING
Address CHASE, KANSAS


STATE OF KANSAS, COUNTY OF RICE
R. DARRELL KELSO (employee of owner) or (owner or operator) of the above-described
well, being first duly sworn on oath, says: That I have knowledge of the facts, statements, and matters herein contained and the log of the
above-described well as filed and that the same are true and correct. So help me God.

(Signature) *R. Darrell Kelso*

Chase, Kansas 67524
(Address) 73

SUBSCRIBED AND SWORN TO before me this 3rd day of April, 1973.

My commission expires

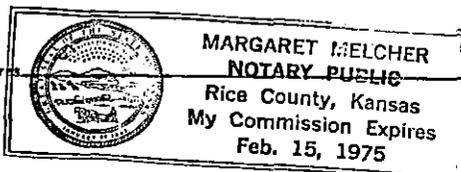

Margaret Melcher
Notary Public.

ROTARY DRILLING LOG

Operator: Rains & Williamson
 Oil Co., Inc.
 LEE #1
 NE NE Sec. 22-29S-13W
 Pratt County, Kansas

Contractor: Rains & Williamson
 Oil Co., Inc.
 Commenced: 10-22-67
 Completed: 11-8-67 (Rotary)

Remarks: Set 13" surface casing at 281' w/ 250 sacks GL-3 cement

 Set 5-1/2" casing at 4669' w/175 sacks salt sat. cement w/ salt flush ahead.

Formations:

Sand	211'
Red Bed	500'
Red Bed and Shale	1178'
Anhydrite	1181'
Shale	1810'
Lime and Shale	1990'
Shale and Lime	2110'
Lime	2215'
Lime and Shale	2425'
Shale and Lime	2535'
Shale	2780'
Shale and Lime	3006'
Lime and Shale	3945'
Lime	4285'
Lime and Chert	4345'
Lime	4532'
Lime and Chert	4564'
Lime	4570'
Lime and Chert	4578'
Sand	4595'
Sand and Shale	4664'
Lime	4667'
Rotary Total Depth	4667'

Perforations 4576-77

RECEIVED
 STATE CORPORATION COMMISSION
 JAN 22 1973
 CONSERVATION DIVISION
 Wichita, Kansas

I certify the above log is true and correct to the best of my knowledge and belief.

RAINS & WILLIAMSON OIL CO., INC.

Wilson Rains

 Wilson Rains

Subscribed and sworn to before me, a Notary Public within and for the State of Kansas, County of Sedgwick, this 15th day of November, 1967.

Sherry Gish

 Sherry Gish Notary Public