


STATE OF KANSAS
STATE CORPORATION COMMISSION
CONSERVATION DIVISION
P. O. BOX 17027
WICHITA, KANSAS 67217

FORM CP-4

WELL PLUGGING RECORD

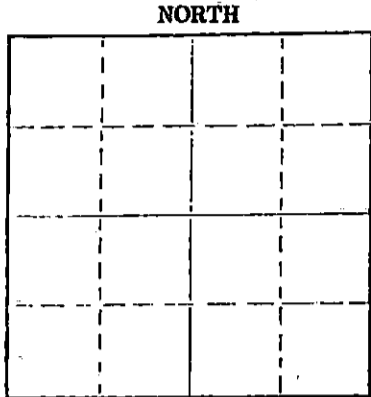

Locate well correctly on above Section Plot

Pratt County, Sec. 18 Twp 29S Rge 13W (E) (W)
Location as "NE/CNW&SW" or footage from lines S/2 SE/4 NW/4
Lease Owner Beren Corporation
Lease Name Bass Well No. 1
Office Address 970 Fourth Financial Center, Wichita, Kansas
Character of Well (completed as Oil, Gas or Dry Hole) Dry Hole
Date well completed August 16 19 76
Application for plugging filed August 16 19 76
Application for plugging approved August 16 19 76
Plugging commenced August 16 19 76
Plugging completed August 16 19 76
Reason for abandonment of well or producing formation dry hole

If a producing well is abandoned, date of last production 19
Was permission obtained from the Conservation Division or its agents before plugging was commenced? Yes, verbally

Name of Conservation Agent who supervised plugging of this well G. R. Biberstein
Producing formation Depth to top Bottom Total Depth of Well 4640 Feet
Show depth and thickness of all water, oil and gas formations.

OIL, GAS OR WATER RECORDS

CASING RECORD

FORMATION	CONTENT	FROM	TO	SIZE	PUT IN	PULLED OUT
				8-5/8"	402	

Describe in detail the manner in which the well was plugged, indicating where the mud fluid was placed and the method or methods used in introducing it into the hole. If cement or other plugs were used, state the character of same and depth placed, from feet to feet for each plug set.

1st plug set at 300' w/35 sacks
2nd plug set at 40' with 15 sacks, 5 sacks in rat hole

RECEIVED
STATE CORPORATION COMMISSION

OCT 15 1976

10-15-76
CONSERVATION DIVISION
Wichita, Kansas

(If additional description is necessary, use BACK of this sheet)
Name of Plugging Contractor Union Drilling Co., Inc.
Address 505 Union Center, Wichita, Kansas 67202

STATE OF KANSAS COUNTY OF SEDGWICK ss.
R. D. Messinger (employee of owner) or (owner or operator) of the above-described

well, being first duly sworn on oath, says: That I have knowledge of the facts, statements, and matters herein contained and the log of the above-described well as filed and that the same are true and correct. So help me God.

(Signature) R. D. Messinger
505 Union Center, Wichita, Kansas

SUBSCRIBED AND SWORN TO before me this 18th day of August 19 76

My commission expires 7-29-78

Donna F. Brown
Notary Public.

CONTRACTOR'S WELL LOG

OPERATOR: Beren Corporation
CONTRACTOR: Union Drilling Co., Inc.
WELL NAME: Bass #1
LOCATION: S/2 SE/4 NW/4 Section 18-29S-13W
Pratt County, Kansas
COMMENCED: August 5, 1976
COMPLETED: August 16, 1976

0	1514	Shale	8-5/8" casing set at 402' with
1514	2195	Shale & Shells	375 sacks
2195	2645	Lime and shale	
2645	2758	Lime	
2758	2830	Lime and shale	
2830	2985	Lime	
2985	3600	Lime and shale	
3600	3940	Shale and lime	
3940	4050	Lime	
4050	4153	Lime and shale	
4153	4311	Lime	
4311	4377	Lime and shale	
4377	4519	Lime	
4519	4529	Lime and shale	
4529	4565	Lime	
4565	4640	Lime and shale	

RECEIVED
STATE CORPORATION COMMISSION

OCT 15 1976

CONSERVATION DIVISION
Wichita, Kansas

We certify that the above and foregoing is a true and correct copy of the log on the #1 Bass, S/2 SE/4 NW/4 Section 18-29S-13W, Pratt County, Kansas.

UNION DRILLING CO., INC.

By R. D. Messinger
R. D. Messinger

STATE OF KANSAS)
) SS
COUNTY OF SEDGWICK)

Subscribed and sworn to before me, a Notary Public in and for the aforesaid county and state as of this 18th day of August, 1976.

Donna F. Brown
Donna F. Brown, Notary Public

My commission expires:

July 29, 1978

