


Give All Information Completely
Make Required Affidavit
Mail or Deliver Report to:
Conservation Division
State Corporation Commission
221 N. Broadway
Wichita, Kansas

WELL PLUGGING RECORD

P.O. Box 17027 Pratt County, Sec. 4 Twp. 29S Rge. (E) 13 (W)
67217 NORTH

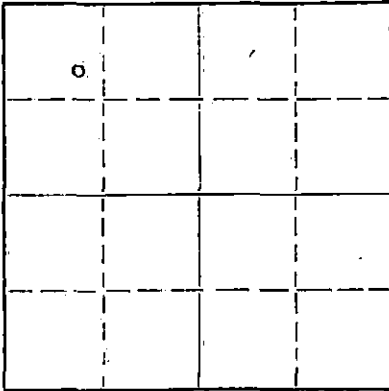

Locate well correctly on above Section Plat

Location as "NE/CNW/SW" or footage from lines SE NW NW
Lease Owner Gibraltar Oil Corporation
Lease Name Barnhart Well No. 1
Office Address 1710 the 600 Bldg., Corpus Christi, Texas 78401
Character of Well (completed as Oil, Gas or Dry Hole) Dry Hole
Date well completed September 24 19 72
Application for plugging filed September 24 19 72
Application for plugging approved September 24 19 72
Plugging commenced September 24 19 72
Plugging completed September 24 19 72
Reason for abandonment of well or producing formation Dry Hole

If a producing well is abandoned, date of last production 19
Was permission obtained from the Conservation Division or its agents before plugging was commenced? Yes

Name of Conservation Agent who supervised plugging of this well G. R. Biberstein
Producing formation Depth to top Bottom Total Depth of Well 4635 Feet
Show depth and thickness of all water, oil and gas formations.

OIL, GAS OR WATER RECORDS

CASING RECORD

FORMATION	CONTENT	FROM	TO	SIZE	PUT IN	PULLED OUT
		0	325'	8 5/8"	325'	None

Describe in detail the manner in which the well was plugged, indicating where the mud fluid was placed and the method or methods used in introducing it into the hole. If cement or other plugs were used, state the character of same and depth placed, from feet to feet for each plug set.

Plug:
300' w/50 sacks cement
40' w/15 sacks cement

RECEIVED
STATE CORPORATION COMMISSION
OCT 2 1972
CONSERVATION DIVISION
Wichita, Kansas
10-02-72


(If additional description is necessary, use BACK of this sheet)

Name of Plugging Contractor Hellar Drilling Company, Inc.
Address 339 Union Center Bldg., Wichita, Kansas 67202

STATE OF Kansas COUNTY OF Sedgwick, ss.
D. L. Hellar, President of Hellar Drilg. Co., Inc. (employee of owner) or (owner or operator) of the above-described

well, being first duly sworn on oath, says: That I have knowledge of the facts, statements, and matters herein contained and the log of the above-described well as filed and that the same are true and correct. So help me God!

(Signature) D. L. Hellar, President
339 Union Center Bldg., Wichita, Kansas 67202
(Address)

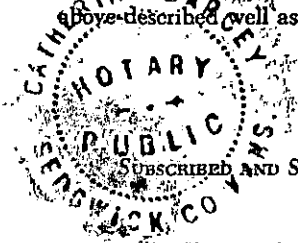

SUBSCRIBED AND SWORN TO before me this 29th day of September, 19 72

Catherine Darcey
Catherine Darcey Notary Public.

My commission expires March 25, 1976.

DRILLER'S LOG

78401

COMPANY: Gibraltar Oil Corporation, 1710 the 600 Bldg., Corpus Christi, Texas
 CONTRACTOR: Hellar Drilling Company, Inc., 339 Union Center Bldg., Wichita, Ks. 67202
 LEASE: #1 Barnhart
 LOCATION: SE NW NW 4-29S-13W, Pratt County, Kansas
 COMMENCED: September 13 1972
 COMPLETED: September 24, 1972
 CASING: Set 8 5/8" Surface Casing @ 325' w/450 sacks cement.

0-145	Sand
145-1091	Red Bed
1091-1725	Shale
1725-2211	Salt Section & Shells
2211-2415	Lime & Shale
2415-2803	Lime & Shale (Ft. Riley)
2803-3896	Lime & Shale
3896-4000	Lime
4000-4214	Lime (L.K.C.)
4214-4309	Lime
4309-4414	Lime (Marmaton)
4414-4479	Lime
4479-4496	Lime-Chert & Shale
4496-4505	Lime
4505-4525	Simpson
4525-4546	Lime & Shale
4546-4635	Shale
4635	Rotary Total Depth

D & A

RECEIVED
 STATE CORPORATION COMMISSION
 OCT 2 1972
 CONSERVATION DIVISION
 Wichita, Kansas


STATE OF KANSAS)
) SS
 COUNTY OF SEDGWICK)

I, D. L. Hellar, do hereby certify that the above and foregoing is a true and correct copy of the log of the #1 Barnhart, located in SE NW NW 4-29S-13W, Pratt County, Kansas, as reflected by the files of the Hellar Drilling Company, Inc.

HELLAR DRILLING COMPANY, INC.

By *D. L. Hellar*
 President - D. L. Hellar


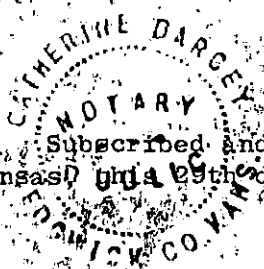

Catherine Darcey
 Notary Public - Catherine Darcey

My Commission Expires:
 March 25, 1976.