

STATE OF KANSAS
STATE CORPORATION COMMISSION
CONSERVATION DIVISION
200 Colorado Derby Building
Wichita, Kansas 67202

FORM CP-1
Rev. 03/92

WELL PLUGGING APPLICATION FORM
(PLEASE TYPE FORM and File ONE Copy)

API # 15-057-20,463-0000 (Identifier number of this well). This must be listed for wells drilled since 1967; if no API# was issued, indicate spud or completion date.

WELL OPERATOR Pickrell Drilling Company, Inc. KCC LICENSE # 5123 ^{6/97}
(owner/company name) (operator's)
ADDRESS 110 N. Market, Suite 205 CITY Wichita

STATE Kansas ZIP CODE 67202 CONTACT PHONE # (316) 262-8427

LEASE McFadden B WELL# 1 SEC. 33 T. 29S R. 22 (~~XXX~~ West)

-S/2 - N/2 - S/2 SPOT LOCATION/QQQQ COUNTY Ford

1540 FEET (in exact footage) FROM S/N (circle one) LINE OF SECTION (NOT Lease Line)

2640 FEET (in exact footage) FROM E/W (circle one) LINE OF SECTION (NOT Lease Line)

Check One: OIL WELL GAS WELL D&A SWD/ENHR WELL DOCKET# _____

CONDUCTOR CASING SIZE _____ SET AT _____ CEMENTED WITH _____ SACKS

SURFACE CASING SIZE 8 5/8 SET AT 515 CEMENTED WITH 275 SACKS

PRODUCTION CASING SIZE 4 1/2 SET AT 5415 CEMENTED WITH 150 SACKS

LIST (ALL) PERFORATIONS and BRIDGEPLUG SETS: 5300-5315

ELEVATION 2440 KB T.D. 5470 PSTD 5376 ANHYDRITE DEPTH Heeb 4384 (-1944)
(G.L./K.B.) (Stone Corral Formation)

CONDITION OF WELL: GOOD POOR CASING LEAK JUNK IN HOLE

PROPOSED METHOD OF PLUGGING Plug back w/ sand to 5225'. Use dump bailer to dump 5 sx. cement on top of sand. Cut and recover casing. Plug top hole as directed by K.C.C. representative (316) 225-6760.

(If additional space is needed attach separate page)

IS WELL LOG ATTACHED TO THIS APPLICATION AS REQUIRED? Yes IS ACO-1 FILED? Yes

If not explain why? 10-9-1996

PLUGGING OF THIS WELL WILL BE DONE IN ACCORDANCE WITH K.S.A. 55-101 et. seq. AND THE RULES AND REGULATIONS OF THE STATE CORPORATION COMMISSION.

LIST NAME OF COMPANY REPRESENTATIVE AUTHORIZED TO BE IN CHARGE OF PLUGGING OPERATIONS:

Ed Mondero PHONE# (913) 798-2430

ADDRESS P.O. Box 375 City/State Ness City, KS 67560

PLUGGING CONTRACTOR Mike's Testing & Salvage, Inc. KCC LICENSE # 31529 ^{9/97}
(company name) (contractor's)

ADDRESS P.O. Box 209 Chase, Kansas 67254 PHONE # (316) 938-2537

PROPOSED DATE AND HOUR OF PLUGGING (If Known?) October 22, 1996


PAYMENT OF THE PLUGGING FEE (K.A.R. 82-3-118) WILL BE GUARANTEED BY OPERATOR OR AGENT

DATE: October 7, 96 AUTHORIZED OPERATOR/AGENT: Jack Gurley
(signature)

BAKER SERVICE TOOLS - TALLY PAD

New Completion Workover

Oil Company _____ Well No. 1 Field _____ Lease McFadden B
Company Man _____ Date Drilled 12/1988 County Ford State Kansas

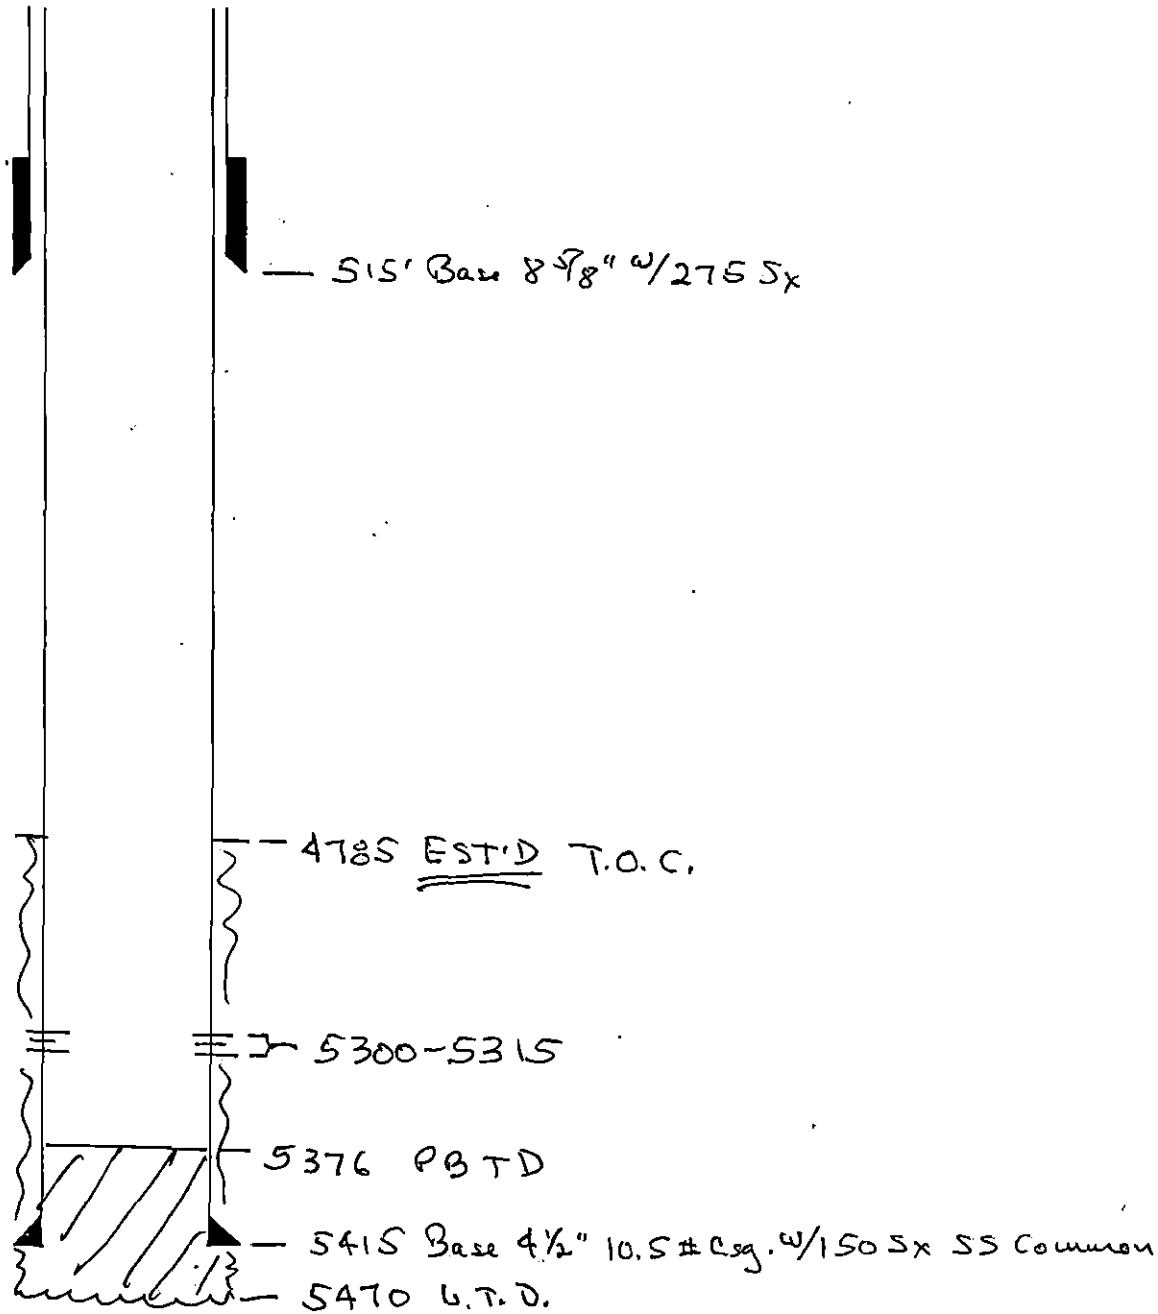

REMARKS: _____

RECEIVED
KANSAS CORP CORP
1988 OCT -9 P 12:02

15-057-20463

Schlumberger

DUAL INDUCTION - SFL

WELL HEAD - OPERATIONAL LOG

COUNTY FORD	FIELD 110' SOUTH OF S/2-N/2-S/2	LOCATION 91 MCFADDEN INC. 'B'	WELL PICKRELL DRILLING COMPANY, INC	COMPANY PICKRELL DRILLING COMPANY, INC.				
				WELL #1 MCFADDEN INC. 'B'				
FIELD				WELL FILE				
COUNTY FORD				STATE KANSAS				
COUNTY FORD	FIELD 110' SOUTH OF S/2-N/2-S	LOCATION 91 MCFADDEN INC. 'B'	WELL PICKRELL DRILLING COMPANY, INC	LOCATION 110' SOUTH OF S/2-N/2-S				Other Services: LDT CNL GR CWL
				API SERIAL NO.	SECT. 33	TWP. 22W	RANGE 22W	
Permanent Datum		GROUND LEVEL		Elev.	2435.0 F	Elev.: K.B.2440.0 F		
Log Measured From		KELLY BUSHING		5.0 F	above Perm. Datum	D.F.2438.0 F		
Drilling Measured From		KELLY BUSHING				G.L.2435.0 F		
Date		19-DEC-88						
Run No.		ONE						
Depth Driller		5475.0 F						
Depth Logger (Schl.)		5470.0 F						
Btm. Log Interval		5464.0 F						
Top Log Interval		511.0 F						
Casing-Driller		8 5/8	516.0 F					
Casing-Logger		511.0 F						
BHT Size		7 7/8						
Type Fluid In Hole		CHEMICAL						
Dens.	Visc.	9.20 LB/G	54.0 S					
pH	Fld. Loss	8.0	16.8 C3					
Source of Sample		PIT						
Rm @ Meas. Temp.		.481 OHMM	60.0 DEGF					
Rmf @ Meas. Temp.		.420 OHMM	62.0 DEGF					
Rmo @ Meas. Temp.		.870 OHMM	67.0 DEGF					
Source: Rmf	Rmo	MEAS	MEAS					
Rm @ BHT		.280 OHMM	108. DEGF					
Time	Circulation Ended		12-19 0000					
	Logger on Bottom		12-16 0415					
Max. Rec. Temp.		108. DEGF						
Equip.	Location	6365	GREAT BEND					
Recorded By		MCLAUGHLIN						
Witnessed By		BILL KLAVER						

The well name, location and borehole reference data were furnished by the customer.

15-057-20463
KANSAS
PICKRELL DRILLING COMPANY



Kansas Corporation Commission

Bill Graves, Governor Timothy E. McKee, Chair Susan M. Seltsam, Commissioner John Wine, Commissioner.
Judith McConnell, Executive Director David J. Heinemann, General Counsel

NOTICE OF RECEIPT OF WELL PLUGGING APPLICATION (CP-1)

October 10, 1996

Pickrell Drilling Company Inc
110 N Market Suite 205
Wichita KS 67202

McFadden B #1
API 15-057-20,463
1540 FSL 2640 FEL
Sec. 33-29S-22W
Ford County

Dear Ed Mondero,

This letter is to notify you that the Conservation Division is in receipt of your plugging proposal, form CP-1, for the above-captioned well.

Your CP-1 has been reviewed by the Conservation Division central office for completeness and to verify license numbers. The plugging proposal will now be forwarded to the district office listed below for review of your proposed method of plugging.

Please contact the district office for approval of your proposed plugging method at least at five (5) days before plugging the well, pursuant to K.A.R. 82-3-113 (b). If a workover pit will be used during the plugging of the well it must be permitted. A CDP-1 form must be filed and approved prior to the use of the pit.

The Conservation Division's review of form CP-1, either in the central or district office, does not include an inquiry into well ownership or the filing operator's legal right to plug the well.

This notice in no way constitutes authorization to plug the above-captioned well by persons not having legal rights of ownership or interest in the well. This notice is void after ninety (90) days from the above date.

Sincerely,

A handwritten signature in cursive script that reads "David P. Williams".

David P. Williams
Production Supervisor

District: #1
304 W. McArtor
Dodge City, KS 67801
(316) 225-6760