

STATE OF KANSAS
STATE CORPORATION COMMISSION

15-057-2012-0000

WELL PLUGGING RECORD

Give All Information Completely
Make Required Affidavit
Mail or Deliver Report to
Conservation Division
State Corporation Comm.
245 North Water
Wichita, KS 67202

Ford County, Sec. 14 Twp. 28S Rge. 21 E/W
Location as "NE/CNW 1/4 SW 1/4" or footage from lines

1570' FSL & 1320' FWL

Lease Owner Texas Oil & Gas Corp.

Lease Name Mann "B" Well No. 1

Office Address 200 W. Douglas, Suite 300, Wichita, KS. 67202

Character of Well (Completed as Oil, Gas or Dry Hole)
Dry Hole

Date Well completed 3-1-78 19

Application for plugging filed 3-1-78 19

Application for plugging approved 3-1-78 19

Plugging commenced 3-1-78 19

Plugging completed 3-1-78 19

Reason for abandonment of well or producing formation


If a producing well is abandoned, date of last production 19

Was permission obtained from the Conservation Division or its agents before plugging was commenced? Yes

Name of Conservation Agent who supervised plugging of this well Bill Owen

Producing formation Depth to top Bottom Total Depth of Well 5200'

Show depth and thickness of all water, oil and gas formations.

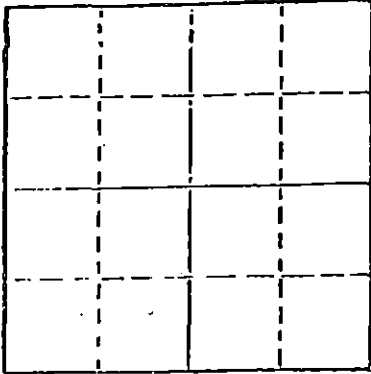

Locate well correctly on above Section Plot

OIL, GAS OR WATER RECORDS

CASING RECORD

FORMATION	CONTENT	FROM	TO	SIZE	PUT IN	PULLED OUT
			0	581'	13 jts.	

Describe in detail the manner in which the well was plugged, indicating where the mud fluid was placed and the method or methods used in introducing it into the hold. If cement or other plugs were used, state the character of same and depth placed, from feet to feet for each plug set.

Plugged hole from T.D. to 900', pump 50 sack cement plug through D.P. mud to 592' 40 sack cement plug mud to 40', 1/2 sacks hulls and plug bridged 20 sack to base of cellar. By Allied Cement Co.

(If additional description is necessary, use BACK of this sheet)

Name of Plugging Contractor Xplor Drilling Co.

STATE OF KANSAS COUNTY OF SEDGWICK, ss.

Kirby C. Evers (employee of owner) or

of the above-described well, being first duly sworn on oath, says: That I have knowledge of the facts, statements, and matters herein contained and the log of the above-described well as filed and that the same are true and correct. So help me God.

(Signature)


Kirby C. Evers

453 S. Webb Rd. Wichita, KS. 67207
(Address)

SUBSCRIBED AND SWORN TO before me this 2nd day of March, 19 78

Virginia Lee Smith
Virginia Lee Smith Notary Public.

My commission expires August 25, 1980

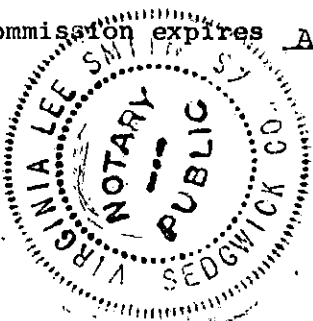

WELL LOG

RECEIVED
MAR 06 1978
RECEIVED

15-057-2012-0000

MANN "B" #1
1570' FSL & 1320' FWL
Section 14-28S-21S
Ford County, Kansas

OPERATOR: TEXAS OIL & GAS CORP.
CONTRACTOR: XPLOR DRILLING CO.

COMMENCED: 2-15-78
COMPLETED: 3-1-78

CASING RECORD: Ran 13 jts. new 8 5/8" 24#, set @581', cement with
400 sacks Light Weight 150 sacks Common 3% cal.chloride
2% gel. By Allied Cementing Co.

FORMATION	FROM	TO	ELEVATION
Lime	0	1271	2374 Gr.
Lime & Shale	1271	1582	2379 D.F.
Red Bed	1582	1675	2382 K.B.
Lime & Shale	1675	5200	
R.T.D.	5200		

RECEIVED
STATE CORPORATION COMMISSION
MAR 07 1978
CONSERVATION DIVISION
Wichita, Kansas

STATE OF KANSAS)
) SS:
COUNTY OF SEDGWICK)

I certify that this is a true and correct copy of the Driller's Log of the well drilled 1570' FSL & 1320' FWL of Section 14-28S-21W, Ford County, Kansas to the best of my knowledge and belief.

XPLOR DRILLING COMPANY

Kirby C. Evers
Kirby C. Evers, Vice President

Subscribed and sworn to before me this 3rd. day of March, 1978.

MY COMMISSION EXPIRES:
August 25, 1980

Virginia Lee Smith
Virginia Lee Smith, Notary Public

