

15-057-20182-0000

WELL PLUGGING RECORD

Give All Information Completely
 Make Required Affidavit

COUNTY Ford SEC. 11 TWP. 28S RGE. 21W E/W
 Location as in quarters or footage from lines:

C. S1/2 N1/2

Lease Owner Pickrell Drilling Company
 Lease Name Hicks A-2 Well No. _____
 Office Address 205 Litwin Bldg. 110 N. Market Wichita, Ks. 67202
 Character of Well (Completed as Oil, Gas or Dry Hole): _____
 Date Well Completed _____
 Application for plugging filed _____
 Plugging commenced 1-8-82
 Plugging completed 1-13-82
 Reason for abandonment of well or producing formation _____

Locate Well
 correctly on above
 Section Platt.

_____ Depleted
 Was permission obtained from the Conservation Division or it's
 Agent's before plugging was commenced? Yes

Name of Conservation Agent who supervised plugging of this well Paul Luthi
 Producing formation _____ Depth to top _____ bottom _____ T.D. 5105'

Show depth and thickness of all water, oil and gas formations.

OIL, GAS OR WATER RECORDS

Casing Record

Formation	Content	From	To	Size	Put in	Pulled Out
				8-5/8"	611'	none
				4-1/2"	5090'	4031'

Describe in detail the manner in which the well was plugged, indicating where the mud fluid was placed and the method or methods used in introducing it into the hold. If cement or other plugs were used, state the character of same and depth placed, from _____ feet to _____ feet for each plug set.

Plugged off bottom with sand to 4900' and set 4 sacks cement. Shot casing @4020', pulled a total of 99 joints of pipe. Plugged well with 5 sacks hulls, 17 sacks gel, 50 sacks cement, 8 sacks gel, 8-5/8" plug, 100 sacks 50/50 pos, 4% gel, 3% cc. Plugging complete.

RECEIVED
 STATE CORPORATION COMMISSION
 JAN 28 1982

CONSERVATION DIVISION
 Wichita, Kansas
 1-28-1982

(If additional description is necessary, use BACK of this sheet)
 Name of Plugging Contractor Kelso Casing Pulling

STATE OF Kansas COUNTY OF Rice, ss.
R. Darrell Kelso (employee of owner) or (owner or operator) of the
 above-described well, being first duly sworn on oath, says: That I have knowledge of the
 facts, statements, and matters herein contained and the log of the above-described well as
 filed and that the same are true and correct. So help me God.

(Signature) R. Darrell Kelso
Box 176 chase, Kansas 67524
 (Address)

SUBSCRIBED AND SWORN TO before me this 27th day of January, 19 82

My Commission expires:



Irene Hoover
 Notary Public.

DAILY DRILLING LOG

COMPANY: Pickrell Drilling Company
205 Litwin Building, 110 North Market
Wichita, Kansas 67202
LOCATION: #2 Hicks 'A'
S/2 N/2, Sec. 11-28S-21W
Ford County, Kansas
CONTRACTOR: PICKRELL DRILLING COMPANY
Wichita, Kansas

Rotary Drilling Commenced 9-30-80
WORK
Rotary Drilling Completed Suspended

15-057-20182-0000

CASING RECORD: Surface pipe 8 5/8", depth 611' KB, cement 295 sx.

LOG

(Figures indicate bottom of formation — measurements from top of rotary bushing.)

Sand	70
Red Beds	100
Shale	2350
Shale & Lime	2790
Lime & Shale	4978
Lime	5033
Mississippian	5105

RECEIVED
STATE CORPORATION COMMISSIONER
NOV 23 1981
CONSERVATION DIVISION
Wichita Kansas

The undersigned, C. W. Sebitts, Attorney-in-Fact for PICKRELL DRILLING COMPANY, hereby certifies in behalf of said Company, that the above is a true and correct log of the formation encountered in drilling the above well as reflected by the Daily Drilling Reports.

PICKRELL DRILLING COMPANY
By [Signature]
Attorney-in-Fact
C. W. Sebitts

STATE OF KANSAS }
COUNTY OF SEDGWICK } ss.:

On this 20 day of March, 1981, before me the undersigned, a Notary Public, in and for the County and State aforesaid, personally appeared C. W. Sebitts, to me known to be the identical person who subscribed the name of PICKRELL DRILLING COMPANY to the foregoing instrument as its Attorney-in-Fact and acknowledged to me that he executed the same as his free and voluntary act and deed, and as the free and voluntary act and deed of such company, for the uses and purposes therein set forth.

Given under my hand and seal of office the day and year last above written.

My commission expires: December 9, 1982

[Signature]
Notary Public
Jana Lea Schneewis

BAKER OIL TOOL & INC.

SERVING THE WORLD


DATE 3-20-81 WELL NO. 7- LEASE HICKS FIELD Pleasant Valley

15-057-20182-0000

ELEV.:

2344 KB

2339 GL

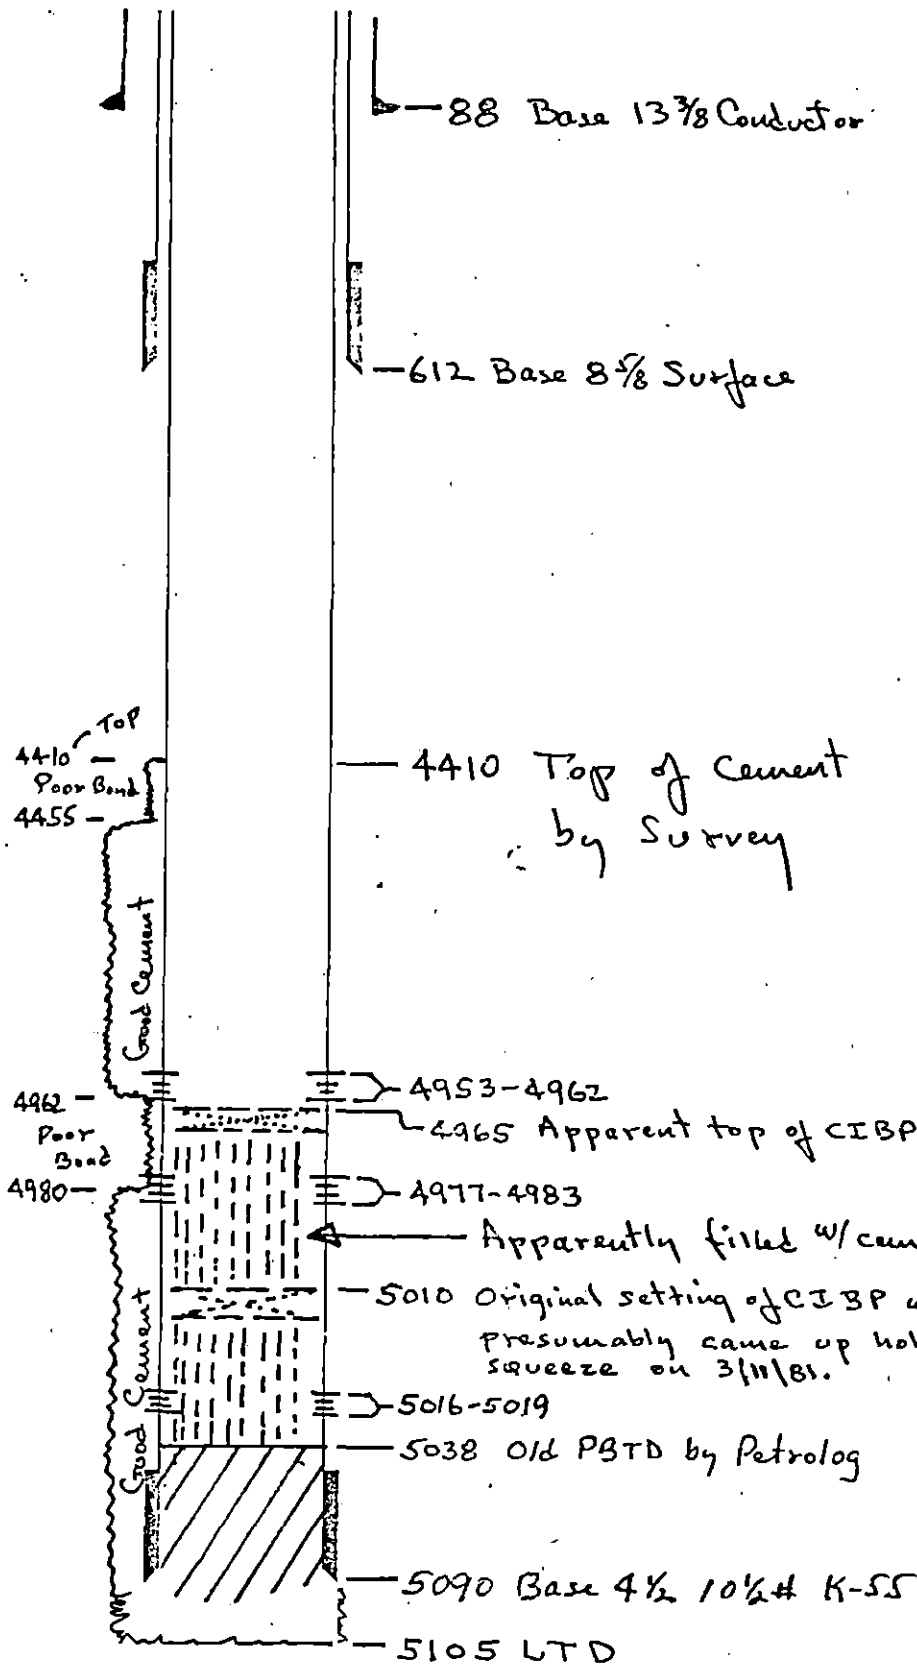

After workover and squeeze job March 1981

RECEIVED
STATE CORPORATION COMMISSION
NOV 23 1981
CONSERVATION DIVISION
Wichita Kansas

