

WELL PLUGGING RECORD

Give All Information Completely
Make Required Affidavit
Mail or Deliver Report to:
Conservation Division
State Corporation Commission
212 North Market, Insurance Bldg.
Wichita, Kansas

Ford County, Sec. 1 Twp. 28 Rge. 21 (E) W (W)

Location as "NE/CNW%SW%" or footage from lines SW SW

Lease Owner Frontier Oil Company

Lease Name Harsha Well No. _____

Office Address 580 Fourth Nat'l Bank Bldg., Wichita, Kansas

Character of Well (completed as Oil, Gas or Dry Hole) D & A

Date well completed September 13 19 60

Application for plugging filed September 13 19 60

Application for plugging approved September 13 19 60


Plugging commenced September 13 19 60

Plugging completed September 13 19 60

Reason for abandonment of well or producing formation D & A

If a producing well is abandoned, date of last production _____ 19 _____

Was permission obtained from the Conservation Division or its agents before plugging was commenced? Yes

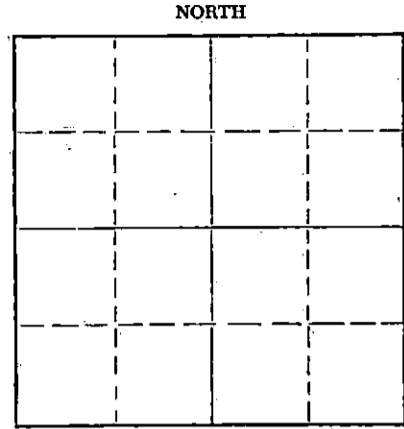

Locate well correctly on above Section Plat

Name of Conservation Agent who supervised plugging of this well Frank Broadfoot

Producing formation _____ Depth to top _____ Bottom _____ Total Depth of Well _____ Feet

Show depth and thickness of all water, oil and gas formations.

OIL, GAS OR WATER RECORDS

CASING RECORD

FORMATION	CONTENT	FROM	TO	SIZE	PUT IN	PULLED OUT
				8 5/8"	400*	-0-

Describe in detail the manner in which the well was plugged, indicating where the mud fluid was placed and the method or methods used in introducing it into the hole. If cement or other plugs were used, state the character of same and depth placed, from _____ feet to _____ feet for each plug set.

Filled with heavy mud to 400*. Set bottom plug @ 400* w/25 sx cement. Set top plug @ 40* w/1/2 sx hulls and 10 sx cement.

RECEIVED
STATE CORPORATION COMMISSION
SEP 23 1960
CONSERVATION DIVISION
Wichita, Kansas
9-23-1960

(If additional description is necessary, use BACK of this sheet)

Name of Plugging Contractor Red Tiger Drilling Company
Address Box 173, Russell, Kansas

STATE OF KANSAS, COUNTY OF SEDGWICK, ss.
George A. Angle (employed or owner) or (owner or operator) of the above-described well, being first duly sworn on oath, says: That I have knowledge of the facts, statements, and matters herein contained and the log of the above-described well as filed and that the same are true and correct. So help me God.

(Signature) George A. Angle
580 Fourth Nat'l Bank Bldg., Wichita
(Address)

SUBSCRIBED AND SWORN to before me this 20th day of September, 19 60

Notary Seal
Notary Public.

My commission expires 11-17-62

DRILLERS LOG

No. 1 Harsha

CASING RECORD: 8 5/8" @ 400* w/275 sx cement
 COMPANY: Frontier Oil Company
 CONTRACTOR: Red Tiger Drilling Company
 COMMENCED: September 6, 1960
 COMPLETED: September 13, 1960
 DESCRIPTION: SW SW 1-28S-21W Ford County, Kansas
 ELEVATION: 2332 DF 2335 RB
 TOTAL DEPTH: 2827*

<u>FORMATION</u>	<u>FROM</u>	<u>TO</u>	<u>REMARKS</u>
Sand	0	20	
Shale Shells	20	400	
Redbed Shale	400	538	
Anhydrite	538	575	
Shale Shells	575	670	
Shale & Shells	670	950	
Shale Shells	950	985	
Shale & Shells	985	1308	
Lime	1308	1320	
Anhydrite	1320	1347	
Shale & Shells	1347	1675	
Shale Shells	1675	2045	
Lime & Shale	2045	2470	
Lime Shale	2470	2531	
Lime & Shale	2531	2685	
Lime	2685	2827	

RECEIVED
 STATE CORPORATION COMMISSION

SEP 23 1960

CONSERVATION DIVISION
 Wichita, Kansas

I certify that this is a true and correct copy of the above log to the best of my knowledge.

FRONTIER OIL COMPANY

George A. Angle

 George A. Angle

Subscribed and sworn to before me this 20th day of September, 1960.

Margie Head

 Notary Public

My Commission Expires:

11-17-62