


15-097-20232-0000

STATE OF KANSAS
STATE CORPORATION COMMISSION

Give All Information Completely
Make Required Affidavit
Mail or Deliver Report to:
Conservation Division
State Corporation Commission
P. O. BOX 17027
Wichita, Kansas 67217

WELL PLUGGING RECORD

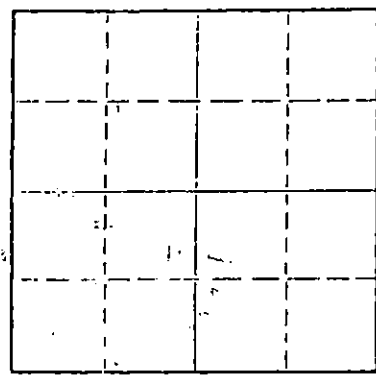

Locate well correctly on above Section Plat

Location as "NE/CNW&SW¼" or footage from lines Kiowa County, Sec. 22 Twp. 28 Rge. 20 (E) (W) X
 Location as "NE/CNW&SW¼" or footage from lines C NW NE
 Lease Owner Okmar Oil Co.
 Lease Name Ray Well No. #1
 Office Address 1130 Vickers KSB&T Bldg. Wichita, Kansas
 Character of Well (completed as Oil, Gas or Dry Hole) _____
 Date well completed _____ 19____
 Application for plugging filed _____ 19____
 Application for plugging approved _____ 19____
 Plugging commenced 7-30-74 19____
 Plugging completed 8-21-74 19____
 Reason for abandonment of well or producing formation _____

If a producing well is abandoned, date of last production _____ 19____
 Was permission obtained from the Conservation Division or its agents before plugging was commenced? _____

Name of Conservation Agent who supervised plugging of this well G. R. Biberstein
 Producing formation _____ Depth to top _____ Bottom _____ Total Depth of Well 4925' Feet
 Show depth and thickness of all water, oil and gas formations.

OIL, GAS OR WATER RECORDS				CASING RECORD		
FORMATION	CONTENT	FROM	TO	SIZE	PUT IN	PULLED OUT
				5 1/2"	4935'	2688.98'
				8 5/8"	539'	


Describe in detail the manner in which the well was plugged, indicating where the mud fluid was placed and the method or methods used in introducing it into the hole. If cement or other plugs were used, state the character of same and depth placed, from _____ feet to _____ feet for each plug set.

Made bottom hole plug back with sand to 4800'. Mixed and ran 5 sacks cement thru dump bailer.
 Mudded hole to 250' - set 10' rock bridge. Filled hole with 4 yards ready-mix concrete to base of cellar.

(If additional description is necessary, use BACK of this sheet)
 Name of Plugging Contractor Southwest Casing Pulling Co.
 Address Box 364 Great Bend, Kansas

STATE OF Kansas COUNTY OF Barton, ss.
Southwest Casing Pulling Co. (employee of owner) or (owner or operator) of the above-described well, being first duly sworn on oath, says: That I have knowledge of the facts, statements, and matters herein contained and the log of the above-described well as filed and that the same are true and correct. So help me God.

(Signature) W. C. Spencer Sec
Box 364 Great Bend, Kansas
 (Address) _____ 19 74

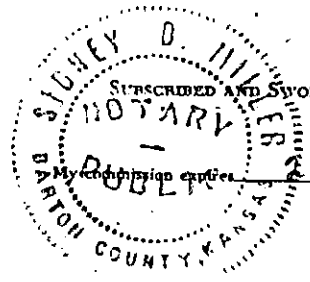

Sworn to before me this 23 day of August, 19 74
Sidney D. Miller
 Notary Public.

RECEIVED
 STATE CORPORATION COMMISSION
 AUG 26 1974
 CONSERVATION DIVISION
 Wichita, Kansas
 8-26-1974

15-097-20232-0000

DRILLERS' LOG

OKMAR OIL COMPANY
No. 1 Ray
C NW NE, Sec. 22-28S-20W
Kiowa County, Kansas

Elevation: 2290 K.B.

Commenced: 5-16-74
Completed: 5-26-74

Surface Casing: 539' of
8-5/8" cemented w/250 sx
60-40 Posmix, 100 sx common
cement, 2% gel, 3% cc.
5-17-74

FORMATION

DEPTH

Surface Hole	0 - 547
Blaine Anhydrite	547 - 555
Red Bed & Shale	555 - 690
Shale	690 - 1250
Stone Corral Anhy.	1250 - 1284
Shale	1284 - 1660
Shale & Lime Streaks	1660 - 2130
Shale & Lime	2130 - 2755
Lime & Shale	2755 - 4310
Lime	4310 - 4930 T.D.

RECEIVED
STATE CORPORATION COMMISSION
JUL 22 1974
CONSERVATION DIVISION
Wichita, Kansas

I do hereby certify that the foregoing statements are true and correct to the best of my knowledge and belief.

D N B DRILLING, INC.

James L. Donelson
JAMES L. DONELSON

STATE OF KANSAS: ss:

Subscribed and sworn to before me, the undersigned, a Notary Public in and for said state, this 30th day of May, 1974.

My Commission Expires:
August 25, 1976

Ella Priess
Ella Priess, Notary Public

Ella Priess
STATE NOTARY PUBLIC
Sedgwick County, Kansas
My Com. Expires Aug. 25, 1976