


STATE OF KANSAS
STATE CORPORATION COMMISSION

Form CP-4

Give All Information Completely
Make Required Affidavit
Mail or Deliver Report to:
Conservation Division
State Corporation Commission
212 No. Market
Wichita, Kansas

WELL PLUGGING RECORD

NORTH

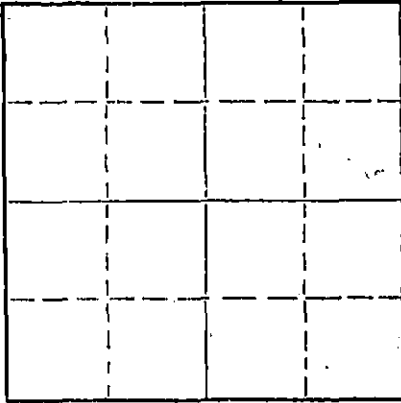

Locate well correctly on above
Section Plat

Kingman County. Sec. 20 Twp. 27S Rge. 5 (W)
Location as "NE/CNW&SW" or footage from lines. Approx. Cen. NE SE SW
Lease Owner Wrico Drilling Co.
Lease Name Pagett Well No. 1
Office Address 6631 E. Kellogg, Wichita, Kansas 67207
Character of Well (completed as Oil, Gas or Dry Hole) Dry Hole
Date well completed October 1 1967
Application for plugging filed Verbal Approval 19
Application for plugging approved Verbal Approval 19
Plugging commenced October 1 1967
Plugging completed October 1 1967
Reason for abandonment of well or producing formation

If a producing well is abandoned, date of last production 19
Was permission obtained from the Conservation Division or its agents before plugging was commenced? Yes

Name of Conservation Agent who supervised plugging of this well Archie V. Elvring
Producing formation Depth to top Bottom Total Depth of Well Feet
Show depth and thickness of all water, oil and gas formations.

OIL, GAS OR WATER RECORDS

CASING RECORD

FORMATION	CONTENT	FROM	TO	SIZE	PUT IN	PULLED OUT
				8-5/8"	209'	None

Describe in detail the manner in which the well was plugged, indicating where the mud fluid was placed and the method or methods used in introducing it into the hole. If cement or other plugs were used, state the character of same and depth placed, from feet to feet for each plug set.

Filled hole with heavy rotary mud from 3,835 feet (rotary total depth) to 200 feet. Set bottom plug at 200 feet and cemented with 25 sacks cement. Filled hole with heavy rotary mud to 40 feet. Set plug at 40 feet and cemented with 10 sacks cement, 2 sacks cement in rat hole.

RECEIVED
STATE CORPORATION COMMISSION
OCT 9 1967
CONSERVATION DIVISION
Wichita, Kansas

Name of Plugging Contractor H-30, Inc.
Address 200 North Main, Wichita, Kansas 67202

STATE OF KANSAS, COUNTY OF SEDGWICK, ss.
Arlo B. Romer (employee of owner) or (owner or operator) of the above-described well, being first duly sworn on oath, says: That I have knowledge of the facts, statements, and matters herein contained and the log of the above-described well as filed and that the same are true and correct. So help me God.

(Signature) Arlo B. Romer
Arlo B. Romer
200 North Main, Wichita, Kansas 67202
(Address)

Subscribed and sworn to before me this 6th day of October, 1967.

Martha Hartpence
Martha Hartpence Notary Public.

My commission expires April 21, 1971

KANSAS GEOLOGICAL SOCIETY
KANSAS WELL LOG BUREAU - KANSAS WELL SAMPLE BUREAU
 KANSAS GEOLOGICAL SOCIETY BUILDING
 508 EAST MURDOCK - WICHITA, KANSAS

COMPANY **Wrico Drilling Co.**


SEC. 20 T27S R. 5W
 LOC. Approx. Cen NE SE SW

FARM **Pagett** NO. 1

COUNTY **Kingman**
 KANSAS

TOTAL DEPTH **3,835'**
 COMM. **September 21, 1967** COMP. **October 1, 1967**

SHOT OR TREATED
 CONTRACTOR **H-30, Inc.**
 ISSUED

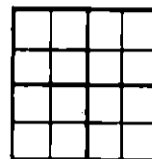

CASING
 20 10
 15 8-5/8" 209' cemented W/175 sacks cement ELEVATION 1481 KB
 12 6
 13 5

PRODUCTION

FIGURES INDICATE BOTTOM OF FORMATIONS

ELECTRIC LOG TOPS:

Shale, Sand & Clay	140	Topeka	2358 - 877
Shale & Shells	212	Heebner Shale	2735 - 1254
Shale	315	Brown Lime	2981 - 1500
Shale & Shells	1040	Lansing K.C.	3004 - 1523
Shale & Lime	1260	Mississippi Chert	3758 - 2277
Lime & Shale	1880	Log T. D.	3835 - 2354
Shale & Lime	3080	Rotary T.D.	3835 - 2354
Lime	3256		
Lime & Shale	3327		
Lime	3457		
Lime & Shale	3730		
Lime & Sand	3806		
Lime	3835		
Rotary Total Depth	3835		

RECEIVED
 STATE CORPORATION COMMISSION
 OCT 9 1967
 CONSERVATION DIVISION
 Wichita, Kansas

I hereby certify the above and foregoing to be a true and correct log of the above described well as shown by the drilling reports.

H-30, Inc.

By Arlo B. Romer
 Arlo B. Romer

STATE OF KANSAS }
 COUNTY OF SEDGWICK } ss

Subscribed and Sworn to before me a Notary Public in and for said county and state this 6th day of October, 1967.

Martha Hartpence
 Martha Hartpence - Notary Public

My Commission Expires:

April 21, 1971