


STATE OF KANSAS
STATE CORPORATION COMMISSION

WELL PLUGGING RECORD

Give All Information Completely
Make Required Affidavit
Mail or Deliver Report to:
Conservation Division
State Corporation Commission
800 Bitting Building
Wichita, Kansas

FORMATION PLUGGING RECORD

Strike out upper line when reporting plugging of formations.

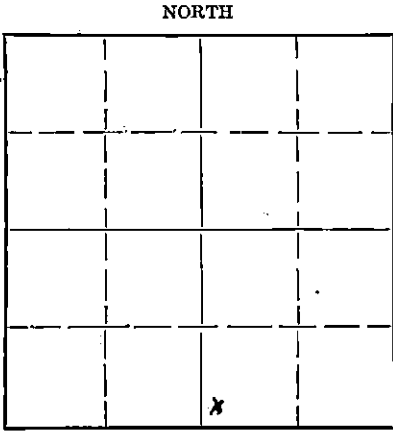

Locate well correctly on above Section Flat

Kingman County. Sec. 28 Twp. 27S Rge. 5W ~~XE~~ (W)
Location as "NE $\frac{1}{4}$ NW $\frac{1}{4}$ SW $\frac{1}{4}$ " or footage from lines SW/4 of SW/4 of SE/4
Lease Owner Drillers Production Co.
Lease Name J. W. Hurn Well No. 1
Office Address 212 North Market St., Wichita 2, Kansas.
Character of Well (completed as Oil, Gas or Dry Hole) Dry Hole
Date well completed February 4, 1951
Application for plugging filed February 4, 1951
Application for plugging approved February 4, 1951
Plugging commenced February 4, 1951
Plugging completed February 4, 1951
Reason for abandonment of well or producing formation No production

If a producing well is abandoned, date of last production 19
Was permission obtained from the Conservation Division or its agents before plugging was commenced? Yes

Name of Conservation Agent who supervised plugging of this well Ruel Durkee
Producing formation Depth to top Bottom Total Depth of Well 3870 Feet
Show depth and thickness of all water, oil and gas formations.

OIL, GAS OR WATER RECORDS

CASING RECORD

Formation	Content	From	To	Size	Put In	Pulled Out
	Surface Pipe Cemented with	175 sacks	of cement.	8 5/8"	257'	
				The cement circulated.		

Describe in detail the manner in which the well was plugged, indicating where the mud fluid was placed and the method or methods used in introducing it into the hole. If cement or other plugs were used, state the character of same and depth placed, from feet to feet for each plug set.
The hole was pumped full of 11# Mud and was bridged at 250' and cemented on top of the bridge with 15 sacks of cement thru' the Drill Pipe. Hole was bridged 8' under the bottom of the cellar and cemented with 5 sacks of cement.

RECEIVED
STATE CORPORATION COMMISSION
FEB 9 1951
CONSERVATION DIVISION
Wichita, Kansas
2-9-51

(If additional description is necessary, use BACK of this sheet)
Correspondence regarding this well should be addressed to The Drillers Production Co.
Address 212 North Market St., Wichita 2, Kansas.

STATE OF Kansas, COUNTY OF _____, SS. _____ (employee of owner) or (owner or operator) of the above-described well, being first duly sworn on oath, says: That I have knowledge of the facts, statements, and matters herein contained and the log of the above-described well as filed and that the same are true and correct. So help me God.

(Signature) Springer & Harper By: L. L. Harper
P. O. Box 1655, Wichita, Kansas (Address)

SUBSCRIBED AND SWORN to before me this 8th day of February, 1951

Bertha L. Wilson
Notary Public.

My commission expires August 13, 1951

PLUGGING
FILE SEC 28 T 27 R 5
BOOK PAGE 64 LINE 7

SPRINGER & HARPER
Drilling Contractors
Box 1655
Wichita, Kansas

February 6, 1951

The Drillers Production Co.,
212 North Market St.,
Wichita 2, Kansas

J. W. Hurn Well #1

Comm. 1-19-51 Compl. 2-1-51
Southwest Quarter (SW/4) of the Southwest Quarter (SW/4) of the Southeast
Quarter (SE/4) of Section Twenty-eight (28) Township Twenty-seven (27) South,
Range Five (5) West, Kingman County, Kansas.

Elevation 1163 Rotary Bushing

Sand & clay	0 - 10
sand	55
gyp red bed & blue shale	230
shale & shells	545
salt & anhydrite	600
salt & shale	800
shale & lime	875
anhydrite	1015
shale	1100
lime	1160
lime & shale	1900
sand	1938
sand & shale	2040
lime	2290
lime & shale	2342
lime	2490
lime	2618
lime	2768
lime & shale	2785
lime	2855
lime & shale	2990
lime	3575
lime & shale	3755
shale	3759
Miss. lime	3775
lime T.D.	3870

Casing Record

Run 257' of 8 5/8"
Surface Pipe and
cemented with 175
sacks of cement.

Formation Tops - Rotary Bushing

Heebner	2719
Lansing	2990
Miss.	3758
Miss. Dolo.	3778

RECEIVED
STATE CORPORATION COMMISSION
FEB 9 1951
CONSERVATION DIVISION
Wichita, Kansas

PLUGGING
FILE SEC 28 T 27 R 5W
BOOK PAGE 60 LINE 47

Springer & Harper

By /s/ L. L. Harper
L. L. Harper

I hereby certify that the above log is a true and correct copy
to the best of my knowledge and belief.

Glen C. Thrasher