


STATE OF KANSAS
STATE CORPORATION COMMISSION

WELL PLUGGING RECORD

Give All Information Completely
Make Required Affidavit
Mail or Deliver Report to:
Conservation Division
State Corporation Commission
800 Bittling Building
Wichita, Kansas

NORTH

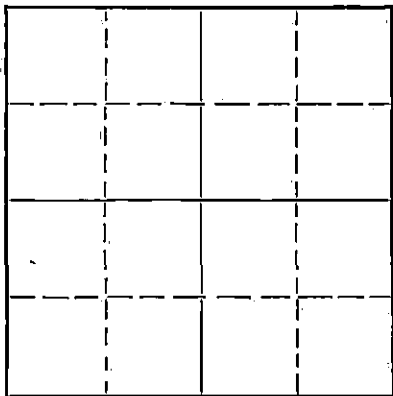

Locate well correctly on above
Section Plat

Kingman County. Sec. 28 Twp. 27S Rge. 5E (E) (W)
Location as "NE/CNW $\frac{1}{4}$ SW $\frac{1}{4}$ " or footage from lines 330' N. of S. Line & 330' E. of W.L.
Lease Owner Orville H. Parker
Lease Name J. W. Hurn Well No. 1
Office Address 219 S. Rutan
Character of Well (completed as Oil, Gas or Dry Hole) dry hole
Date well completed Aug. 6, 1951 19
Application for plugging filed Sept. 17, 1951 19
Application for plugging approved same date 19
Plugging commenced Sept. 17, 1951 19
Plugging completed Sept. 21, 1951 19
Reason for abandonment of well or producing formation Not enough oil and gas to be commercial
If a producing well is abandoned, date of last production _____ 19
Was permission obtained from the Conservation Division or its agents before plugging was commenced? yes

Name of Conservation Agent who supervised plugging of this well Ruel Derke
Producing formation _____ Depth to top _____ Bottom _____ Total Depth of Well _____ Feet
Show depth and thickness of all water, oil and gas formations.

OIL, GAS OR WATER RECORDS

CASING RECORD

Formation	Content	From	To	Size	Put In	Pulled Out
Mississippi Lime	oil, gas & water	3787	3797	5 $\frac{1}{2}$ " OD	3826'	3172'

Describe in detail the manner in which the well was plugged, indicating where the mud fluid was placed and the method or methods used in introducing it into the hole. If cement or other plugs were used, state the character of same and depth placed, from _____ feet to _____ feet for each plug set.

Filled with mud to 3780 and cemented to 3745 with six sacks
Filled with mud to 250' and cemented to 210' with 15 sacks
Filled with mud to 15' and cemented to celler with 5 sacks

Pulled 3172' of 5 $\frac{1}{2}$ " OD, 1 $\frac{1}{2}$ " casing and left 8-5/8" surface pipe in hold.

This well was drilled by Drillers Gas Co. and plugged by them. In July, 1951 drilled out plug and circulated out hole and set 3826 ft. of 5 $\frac{1}{2}$ " OD, 1 $\frac{1}{2}$ " pipe but could not make a commercial well.

RECEIVED
STATE CORPORATION COMMISSION
OCT 23 1951
CONSERVATION DIVISION
Wichita, Kansas
10-3-51

Name of Plugging Contractor Morgan Well Plugging Service
Address 102 West 18th St.
Hutchinson, Kansas

STATE OF Kansas, COUNTY OF Sedgwick, ss.
Orville H. Parker, owner (employee of owner) or (owner or operator) of the above-described well, being first duly sworn on oath, says: That I have knowledge of the facts, statements, and matters herein contained and the log of the above-described well as filed and that the same are true and correct. So help me God.

(Signature) Orville H. Parker
219 So. Rutan, Wichita, Kansas
(Address)

SUBSCRIBED AND SWORN to before me this 2nd day of October, 19 51

My commission expires Feb 4, 1953
Grace R. Petty
Notary Public.

PLUGGING
FILE SEC 24 T 27 R SW
BOOK 111 LINE 45