


STATE OF KANSAS
STATE CORPORATION COMMISSION

WELL PLUGGING RECORD

Give All Information Completely
Make Required Affidavit
Mail or Deliver Report to:
Conservation Division
State Corporation Commission
800 Bitting Building
Wichita, Kansas

Kingman County. Sec. 2 Twp. 27S Rge. 5 (E) (W)
Location as "NE/CNW $\frac{1}{4}$ /SW $\frac{1}{4}$ " or footage from lines NW $\frac{1}{4}$ NW $\frac{1}{4}$ SW $\frac{1}{4}$
Lease Owner Virginia Drilling Co., Inc.
Lease Name Hamman Well No. 1
Office Address 701 Brown Building, Wichita 2, Kansas
Character of Well (completed as Oil, Gas or Dry Hole) dry hole
Date well completed July 7 19 51
Application for plugging filed July 7 19 51
Application for plugging approved July 7 19 51
Plugging commenced July 7 19 51
Plugging completed July 7 19 51
Reason for abandonment of well or producing formation dry hole
If a producing well is abandoned, date of last production 19
Was permission obtained from the Conservation Division or its agents before plugging was commenced? yes

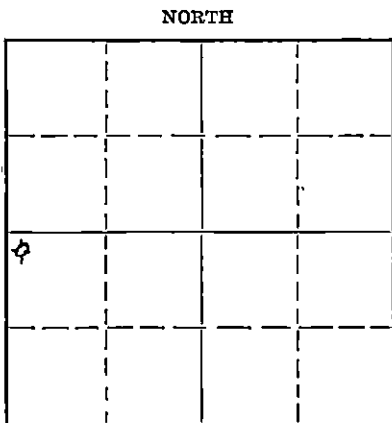

Locate well correctly on above Section Plat

Name of Conservation Agent who supervised plugging of this well Mr. Durkey, McPherson, Kansas
Producing formation _____ Depth to top _____ Bottom _____ Total Depth of Well _____ Feet
Show depth and thickness of all water, oil and gas formations.

OIL, GAS OR WATER RECORDS

CASING RECORD

Formation	Content	From	To	Size	Put In	Pulled Out
				8-5/8"	223'	none

Describe in detail the manner in which the well was plugged, indicating where the mud fluid was placed and the method or methods used in introducing it into the hole. If cement or other plugs were used, state the character of same and depth placed, from _____ feet to _____ feet for each plug set.

Mudded to 215 feet
Plug set with 15 sacks cement
Mudded to 15 feet
Plug set with 5 sacks cement

RECEIVED
STATE CORPORATION COMMISSION

JUL 11 1951

7-11-51

Wichita, Kansas (If additional description is necessary, use BACK of this sheet)

Correspondence regarding this well should be addressed to Virginia Drilling Co., Inc.
Address 701 Brown Bldg., Wichita 2, Kansas

STATE OF Kansas, COUNTY OF Sedgwick, ss.
S. A. Murphy (employee of owner) or (owner or operator) of the above-described well,
being first duly sworn on oath, says: That I have knowledge of the facts, statements, and matters herein contained and the log of the above-described well as filed and that the same are true and correct. So help me God.

(Signature) S. A. Murphy
701 Brown Bldg., Wichita 2, Kansas
(Address)

SUBSCRIBED AND SWORN to before me this 10th day of July, 19 51

Inez M. Newman
Notary Public.

My commission expires March 15, 1954

PLUGGING
FILE SEC 2 T 27 R 5W
BOOK PAGE 93 LINE 32

Well: Hamman #1
 Location: NW/4 NW/4 SW/4 Section 2-27s-5w, Kingman County, Kansas
 Company: Virginia Drilling Co., Inc. et al
 Contractor: Virginia Drilling Co., Inc.
 Commenced: June 11, 1951
 Completed: July 7, 1951
 Total Depth: 4275
 Elevation: 1456 D.F.

FORMATION	DEPTH		
Sand-gravel	0-70	Set 8-5/8" csg. @ 223'	
Shale-shells	70-223		
Shell-shale	223-700		
Salt-shale	700-770		
Shale-sandy lime	770-955	TOPS:	
Shale-lime	955-1765	Brown Lime	2910'
Shale-sand	1765-1860	Lensing	2944
Lime-shale	1860-2310	Mississippian	3682
Sand-shale	2310-2375	Misener	4037
Lime-shale	2375-3115	Viola	4108
Lime	3115-3456	Simpson	4122
Lime-shale	3456-3682	Arbuckle	4223
Miss. Lime	3682-3690		
Miss. Lime & Chert	3690-3730		
Lime-chert	3730-3804		
Chert	3804-3839		
Lime (Hard)	3839-3863		
Lime-shale	3863-3924		
Lime-chert	3924-3928		
Lime-shale-chert	3928-3956		
Lime-shale	3956-4108		
Viola Lime	4108-4122		
Simpson shale	4122-4126		
Simpson sand	4126-4142		
Lime-shale-chert	4142-4161		
Lime-shale	4161-4174		
Sand-shale	4174-4198		
Sandy-shale	4198-4221		
Lime-shale	4221-4252		
Arbuckle	4252-4275		

Now comes S. A. Murphy, who states that he is familiar with the drilling of oil and gas wells and knows of his own knowledge that the Hamman #1, located in the NW/4 NW/4 SW/4 Section 2-27s-5w, Kingman County, Kansas, was drilled to a total depth of 4275 feet. Same was plugged and abandoned.

RECEIVED
 STATE CORPORATION COMMISSION

JUL 11 1951

Subscribed and sworn to before me this 10th day of July, 1951.
 Wichita, Kansas

S. A. Murphy
J. M. Newman

My commission expires March 15, 1954.

PLUGGING
 NW/4 SEC-27-27-5w
 ECCC PAGE 93 LINE 37