


WELL PLUGGING RECORD

Give All Information Completely
Make Required Affidavit
Mail or Deliver Report to:
Conservation Division
State Corporation Commission
800 Bitting Building
Wichita, Kansas

NORTH

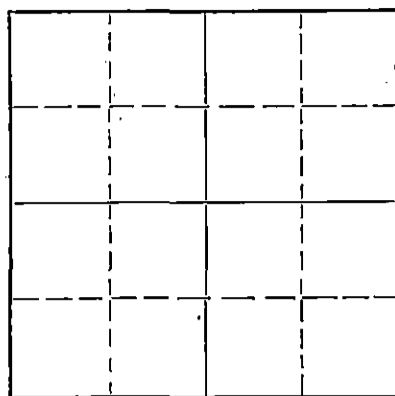

Locate well correctly on above
Section Flat

Kiowa County. Sec. 11 Twp. 28 Rge. (E) 20 (W)
Location as "NE/CNWxSWx" or footage from lines SW SE NE
Lease Owner M. B. Armer
Lease Name Sherer Well No. 1
Office Address 710 Petroleum Building - Wichita, Kansas
Character of Well (completed as Oil, Gas or Dry Hole) Dry Hole
Date well completed March 19 19 56
Application for plugging filed March 19 19 56
Application for plugging approved March 19 19 56
Plugging commenced March 19 19 56
Plugging completed March 19 19 56
Reason for abandonment of well or producing formation Dry Hole

If a producing well is abandoned, date of last production 19
Was permission obtained from the Conservation Division or its agents before plugging was commenced? Yes

Name of Conservation Agent who supervised plugging of this well M. A. Rives - Mullinville, Kansas
Producing formation Depth to top Bottom Total Depth of Well 4937 Feet
Show depth and thickness of all water, oil and gas formations.

OIL, GAS OR WATER RECORDS

CASING RECORD

FORMATION	CONTENT	FROM	TO	SIZE	PUT IN	PULLED OUT
				8-5/8"	226'	

Describe in detail the manner in which the well was plugged, indicating where the mud fluid was placed and the method or methods used in introducing it into the hole. If cement or other plugs were used, state the character of same and depth placed, from feet to feet for each plug set.

Hole filled with heavy mud to 205' with 1/3 sacks of hulls and 20 sacks of cement.
First Plug Set.

Hole filled with heavy mud to 35', plug set with 1/3 sacks of hulls, 10 sacks of cement.

(If additional description is necessary, use BACK of this sheet)

Name of Plugging Contractor Strata Drilling, Inc.
Address McBride Building - Great Bend, Kansas

STATE OF KANSAS, COUNTY OF BARTON, ss.
Charles W. Steincamp (Employee of owner) or (Owner) operator of the above-described well, being first duly sworn on oath, says: That I have knowledge of the facts, statements, and matters herein contained and the log of the above-described well as filed and that the same are true and correct. So help me God.

(Signature) Charles W. Steincamp
McBride Building - Great Bend, Kansas
(Address)

SUBSCRIBED AND SWORN TO before me this 24th day of March, 19 56

My commission expires November 21, 1959

Mary C. Johnson
Notary Public.

24-7998-6 3-53-20M

RECEIVED
STATE CORPORATION COMMISSION

MAR 27 1956
CONSERVATION DIVISION
Wichita, Kansas
3-27-56

PLUGGING
FILE SEC 11 T 28 R 20W
BOOK PAGE 46 LINE 40

DRILLERS LOG

15-097-10006-0000

Company: M. B. Armer Location: SW SE NE
 Contractor: Strata Drilling, Inc. Section 11-28S-20W
 Farm Name: Sherer #1 Elevation: 2302' KB
 Commenced: March 6, 1956 Casing: 266' used 8-5/8" casing
 Completed: March 19, 1956

0' - 65 Soil and Sand
 216 Sand and Shale
 515 Shale
 590 Sand
 700 Red Bed
 720 Anhydrite
 945 Red Bed
 1255 Shale and Shell
 1270 Anhydrite
 1720 Shale and Lime
 2195 Shale and Shells
 2445 Shale and Lime
 2540 Lime (Cherty)
 2805 Lime and Shale
 2895 Cherty Lime
 3935 Shale and Lime
 4040 Lime
 4300 Shale and Lime
 4932 Lime
 4932' KB Total Depth

STATE OF KANSAS)
) SS.
 COUNTY OF BARTON)

I, the undersigned, being duly sworn on oath, state that the above statement and log are true and a correct record and log of the well drilled at the location above described.

STRATA DRILLING, INC.

Charles W. Steincamp
 Charles W. Steincamp President

Subscribed and sworn before me this 24th day of March, 1956

Mary O. [Signature]
 Notary Public

My Commission Expires November 21, 1959

PLUGGING
 SEC 11 T 28 R 20W
 PAGE 46 LINE 40