


WELL PLUGGING RECORD

Give All Information Completely
Make Required Affidavit
Mail or Deliver Report to:
Conservation Division
State Corporation Commission
800 Biting Building
Wichita, Kansas

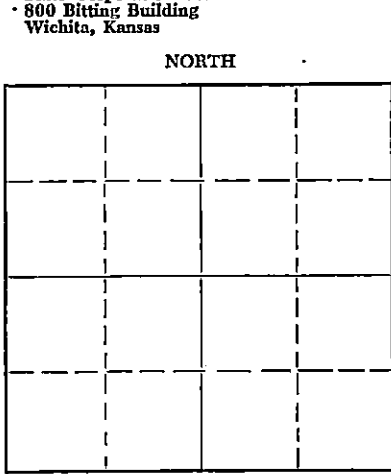

Locate well correctly on above Section Plat

Kiowa County. Sec. 11 Twp. 28S Rge. KKX 20(W)
Location as "NE/CNW/SE/SW" or footage from lines 990' fr. W, 330' fr. N, SE/4
Lease Owner Phillips Petroleum Company
Lease Name Ralstin "A" Well No. 1
Office Address Box 779, Great Bend, Kansas
Character of Well (completed as Oil, Gas or Dry Hole) Dry Hole
Date well completed January 25, 19 56
Application for plugging filed January 26, 19 56
Application for plugging approved January 27, 19 56
Plugging commenced February 3, 19 56
Plugging completed February 8, 19 56
Reason for abandonment of well or producing formation Dry Hole

If a producing well is abandoned, date of last production - - 19
Was permission obtained from the Conservation Division or its agents before plugging was commenced? Yes

Name of Conservation Agent who supervised plugging of this well Mr. M. A. Rives
Producing formation Depth to top Bottom Total Depth of Well PB 4917 Feet
Show depth and thickness of all water, oil and gas formations. OTD 4994

OIL, GAS OR WATER RECORDS				CASING RECORD		
FORMATION	CONTENT	FROM	TO	SIZE	PUT IN	PULLED OUT
Heebner	Dry	4124	4144	8-5/8"	295.92 OA	None
Toronto	Dry	4144	4162	5-1/2"	4983.08 OA	2900'
Douglas	Dry	4162	4275			
Lansing-Kansas City	Dry	4275	4650			
Marmaton	Dry	4655	4825			
Cherokee	Dry	4825	4894			
Mississippian	Dry	4894	4994			

Describe in detail the manner in which the well was plugged, indicating where the mud fluid was placed and the method or methods used in introducing it into the hole. If cement or other plugs were used, state the character of same and depth placed, from feet to feet for each plug set.

Plugged back with sand from 4917' to 4905'. 5 sx. cement to 4880'. Mudded hole from 4880' to 300'. Set rock bridge 300' to 290'. Dumped 20 sx. cement 290' to 190'. Mudded hole to 35'. Set rock bridge 35' to 25'. Dumped 10 sx. cement from 25' to base of cellar. Well Plugged and abandoned 4:00 P.M. 2-8-56. FINAL REPORT.

(If additional description is necessary, use BACK of this sheet)
Name of Plugging Contractor West Supply Company
Address Chase, Kansas

STATE OF Kansas, COUNTY OF Barton, ss.
A. J. Willis (employee of owner) or (owner or operator) of the above-described well, being first duly sworn on oath, says: That I have knowledge of the facts, statements, and matters herein contained and the log of the above-described well as filed and that the same are true and correct. So help me God.

(Signature) A. J. Willis
Box 779, Great Bend, Kansas
(Address)

SUBSCRIBED AND SWORN to before me this 9th day of February, 19 56

My commission expires: November 18, 1957 Joseph M. Beal Notary Public.

PLUGGING
REC SEC 11 TWP 28 R 20W
BOOK PAGE 34 LINE 25

15-097-10153-0000

Phillips Petroleum Company

EXPLORATION RECORD

Ralstin "A" #1 - 990' from West and 330' from North Lines,
SE/4 Sec. 11-28S-20W, Kiowa County, Kansas.
DRY HOLE

Lease Ralstin "A"

Well 1

Formation Name	Top	Base	Remarks
Soll and sand	0	40	
Sand	40	90	
Sand and shale	90	420	
Shale	420	583	
Redbed	583	610	
Sand	610	715	
Anhydrite	715	735	
Redbed	735	795	
Shale and shells	795	1410	
Redbed and shale	1410	1820	
Shale and shells with salt	1820	2110	
Shale and shells	2110	2330	
Lime and shale	2330	3593	
Sand and shale	3593	3740	
Lime and shale	3740	4080	
Lime	4080	4785	
Lime and chert	4785	4815	
Lime	4815	4895	
Lime and chert	4895	4910	
Lime	4910	4994	

FORMATION TOPS (Sample)

*Not penetrated at 4994' TD

Neobner	4124
Toronto	4144
Douglas	Not picked (4162 Halliburton)
Lansing-Kansas City	4275
Base-Kansas City	4650
Harmaton	4655
Cherokee	4825
Mississippian	4894
Rotary Total Depth	4994
Cable Tool Total Depth PD	4917

STATE CORP. COMMISSION
COLLECTOR

PLUGGING
WELL ORG. 11 28 R 20W
BOOK PAGE 34 LINE 25