


WELL PLUGGING RECORD

Give All Information Completely  
Make Required Affidavit  
Mail or Deliver Report to:  
Conservation Division  
State Corporation Commission  
211 No. Broadway  
Wichita, Kansas

Kiowa County, Sec. 11 Twp. 28 Rge. (E) 20 (W)  
Location as "NE/CNW/SE/SW" or footage from lines SE SW NE  
Lease Owner Rupp-Ferguson Oil Co.  
Lease Name McKinley Well No. 1  
Office Address 522 Union Center, Wichita, Kansas  
Character of Well (completed as Oil, Gas or Dry Hole) Oil Well  
Date well completed 5-22-55 19  
Application for plugging filed 7/24/59 19  
Application for plugging approved 7/28/59 19  
Plugging commenced 8/13/59 19  
Plugging completed 8/17/59 19  
Reason for abandonment of well or producing formation Depleted

NORTH

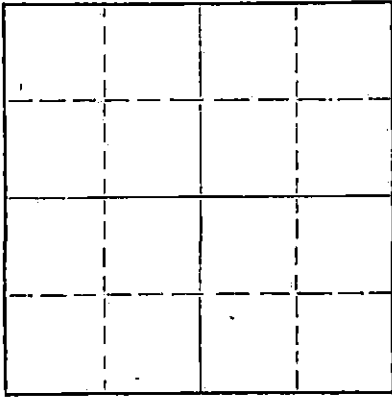

Locate well correctly on above  
Section Plat

If a producing well is abandoned, date of last production 19  
Was permission obtained from the Conservation Division or its agents before plugging was commenced? Yes

Name of Conservation Agent who supervised plugging of this well W. L. Lackamp, Stafford, Kansas  
Producing formation \_\_\_\_\_ Depth to top \_\_\_\_\_ Bottom \_\_\_\_\_ Total Depth of Well 4195 Feet  
Show depth and thickness of all water, oil and gas formations.

OIL, GAS OR WATER RECORDS

CASING RECORD

FORMATION	CONTENT	FROM	TO	SIZE	PUT IN	PULLED OUT
					3105'	3112'

Describe in detail the manner in which the well was plugged, indicating where the mud fluid was placed and the method or methods used in introducing it into the hole. If cement or other plugs were used, state the character of same and depth placed, from \_\_\_\_\_ feet to \_\_\_\_\_ feet for each plug set.

Mudded from 4850' to 250' rock bridge from 250' to 240' run 20 sacks cement from 240' to 180' mudded from 180' to 40' rock bridge from 40' to 30' and run 10 sacks cement to base of cellar.

RECEIVED  
STATE CORPORATION COMMISSION

JUN 19 1961 6-19-61

CONSERVATION DIVISION  
Wichita, Kansas

(If additional description is necessary, use BACK of this sheet)  
Name of Plugging Contractor Glenn & Smith Pipe Pulling Co.  
Address Box 114, Ellinwood, Kansas

STATE OF Kansas, COUNTY OF Sedgwick, ss.  
J. F. Carter, Jr., Petroleum Engineer (employee of owner) or (owner or operator) of the above-described well, being first duly sworn on oath, says: That I have knowledge of the facts, statements, and matters herein contained and the log of the above-described well as filed and that the same are true and correct. So help me God.

(Signature)

522 Union Center, Wichita, Kansas  
(Address)

J. F. Carter, Jr.

SUBSCRIBED AND SWORN TO before me this 18th day of August, 19 59

My commission expires May 11, 1963

Marguerite Dickey  
Marguerite Dickey Notary Public.



KANSAS GEOLOGICAL SOCIETY  
 KANSAS WELL LOG BUREAU - KANSAS WELL SAMPLING BUREAU  
 KANSAS GEOLOGICAL SOCIETY BUILDING  
 508 EAST MURDOCK - WICHITA, KANSAS

15-097-00003-0000


COMPANY M. B. Armer  
 FARM McKinley NO. 1

SEC. 11 T. 28 R. 20W  
 LOC. SE SW NE

TOTAL DEPTH 4915  
 COMM. 4/28/55 COMP. 5/17/55  
 SHOT OR TREATED  
 CONTRACTOR M. B. Armer  
 ISSUED

COUNTY Kiowa

KANSAS

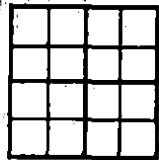

CASING  
 20 10  
 15 8 203  
 12 6  
 13 5 4915'

ELEVATION 2299 K.B.

PRODUCTION

FIGURES INDICATE BOTTOM OF FORMATIONS

Sand	90
Sand & Shells	630
Lime - "Sticky"	213
Shale & Shells	550
Sand	651
Red Bed	715
Anhydrite	730
Shale, Shells & Sand strks.	1030'
Shale & Sand	1200
Shale & Shells	1900
Shale & Lime	2365
Broken Lime	2370
Shale & Lime	2465
Lime	2525
Shale & Lime	3735
Shale	3840
Shale & Lime	3942
Lime	4053
Shale & Lime	4305
Lime	4351
Shale & Lime	4375
Lime	4682
Shale & Sandy Lime	4720
Lime	4755
Shale & Lime	4833
Lime	4863
Shale & Lime	4897
Lime & Chert	4805
Chert	4915

RECEIVED  
 STATE CORPORATION COMMISSION  
 JUL 27 1959  
 CONSERVATION DIVISION  
 Wichita, Kansas

FORMATION TOPS

HEEBNER	4119
BROWN LIME	4271
LANSING	4284
BASE KANSAS CITY	4646
MISSISSIPPIAN	4884

I hereby certify that this is a true and correct log of the above described well as shown by the drilling reports.

M. B. ARMER

By *L. C. Spinning*

STATE OF KANSAS  
 COUNTY OF SEDGWICK

SS:

PLUGGING  
 FILE SEC. 11 T. 28 R. 20W  
 BOOK PAGE 53 LINE 30

Subscribed and sworn to before me, a notary public, in and for said County and State this 18th day of May, 1955.

My Commission expires February 13, 1956.

*Rose Lurvey*  
 Notary Public