

STATE OF KANSAS
STATE CORPORATION COMMISSION


15-097-30016-00-0

WELL PLUGGING RECORD

Give All Information Completely
Make Required Affidavit
Mail or Deliver Report to
Conservation Division
State Corporation Comm.
245 North Water
Wichita, KS 67202

Kiowa County. 4 Sec. 28 Twp. 20 Rge. E/W
Location as "NE/CNW $\frac{1}{2}$ SW $\frac{1}{2}$ " or footage from lines SE SE

Lease Owner William Gruenerwald Ass. Inc.
Lease Name _____ Price _____ Well No. 1
Office Address Box 909 Colorado Springs, Colorado 80901
Character of Well (Completed as Oil, Gas or Dry Hole) _____

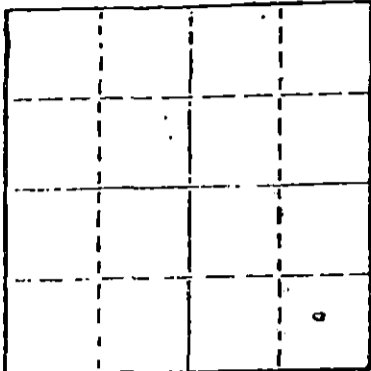

Locate well correctly on above Section Plat

Gas
Date Well completed July 1976
Application for plugging filed 9-29 1980
Application for plugging approved 9-30 1980
Plugging commenced 10-15 1980
Plugging completed 10-18 1980

Reason for abandonment of well or producing formation Uneconomical
If a producing well is abandoned, date of last production July 1979

Was permission obtained from the Conservation Division or its agents before plugging was commenced? Yes

Name of Conservation Agent who supervised plugging of this well Bill Owen
Producing formation Mississippi Depth to top 4908 Bottom 4970 Total Depth of Well 4986
Show depth and thickness of all water, oil and gas formations.

OIL, GAS OR WATER RECORDS

CASING RECORD

FORMATION	CONTENT	FROM	TO	SIZE	PUT IN	PULLED OUT
Mississippi	Gas	4908	4932	8 5/8	499	none
				5 1/2	4986	3528

Describe in detail the manner in which the well was plugged, indicating where the mud fluid was placed and the method or methods used in introducing it into the hold. If cement or other plugs were used, state the character of same and depth placed, from _____ feet to _____ feet for each plug set.

Pump 1 sk. of hulls & 35 sks. of cement to 4300 ft.
Spot 35 sks. of cement @ 624 to 524
Spot 35 sks. of cement @ 400 to 300
Put 10 sks. of cement @ 40 to 0 Cut off & cap 8 5/8 3' below ground level

(If additional description is necessary, use BACK of this report)

Name of Plugging Contractor Sargents Casing Pulling Ser. Box 506 Liberal, Kansas 67351

RECEIVED

NOV 14 1980

11-14-80

STATE OF Colorado COUNTY OF El Paso
William Gruenerwald & Associates, Inc. (employee of owner) Wichita, Kansas (operator)

of the above-described well, being first duly sworn on oath, says: That I have knowledge of the facts, statements, and matters herein contained and the log of the above-described well as filed and that the same are true and correct. So help me God.

(Signature) A.J. Smith Production Superintendent
A.J. Smith P.O. Box 909, Colo. Spgs, Colo 80901
(Address)

SUBSCRIBED AND SWORN TO before me this 10 day of November, 19 80

Janet B. Lindwall
Notary Public.

My commission expires June 12, 1982