


15-097-10206-0000

STATE OF KANSAS
STATE CORPORATION COMMISSION
CONSERVATION DIVISION
P. O. BOX 17027
WICHITA, KANSAS 67217

FORM CP-4

WELL PLUGGING RECORD

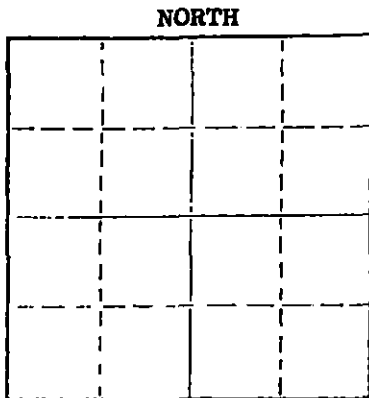

Locate well correctly on above Section Plat

Kiowa County. Sec. 4 Twp. 28S Rge. 20 (E) (W) X
Location as "NE/CNW&SW&" or footage from lines. C-NW-NE 100'S NW 1/2 NW 1/2
Lease Owner. Wm. Gruenerwald & Ass. Inc.
Lease Name. Effie Price Well No. 1
Office Address. Box 909 Colorado Springs, Colorado 80901
Character of Well (completed as Oil, Gas or Dry Hole) _____
Date well completed _____ 19____
Application for plugging filed _____ 19____
Application for plugging approved _____ 19____
Plugging commenced _____ 8-25 _____ 1975
Plugging completed _____ 8-27 _____ 1975
Reason for abandonment of well or producing formation _____
If a producing well is abandoned, date of last production _____ 19____
Was permission obtained from the Conservation Division or its agents before plugging was commenced? Yes

Name of Conservation Agent who supervised plugging of this well Russell Bibberstien
Producing formation _____ Depth to top _____ Bottom _____ Total Depth of Well 5025 Feet
Show depth and thickness of all water, oil and gas formations.

OIL, GAS OR WATER RECORDS

CASING RECORD

FORMATION	CONTENT	FROM	TO	SIZE	PUT IN	PULLED OUT
				4 1/2	5024	1866
				8 5/8	570	none

Describe in detail the manner in which the well was plugged, indicating where the mud fluid was placed and the method or methods used in introducing it into the hole. If cement or other plugs were used, state the character of same and depth placed, from _____ feet to _____ feet for each plug set.

Pumped 2 sks. of hulls & 15 sks. of cement to 4700
Pumped 35 sks. of cement @ 570 to 470
Put Bridge & 10 sks. of cement @ 40 to 0

RECEIVED
STATE CORPORATION COMMISSION

JAN 12 1976 1-12-76

CONSERVATION DIVISION
Wichita, Kansas

(If additional description is necessary, use BACK of this sheet)
Name of Plugging Contractor Sargents Casing Pulling Service Kansas No. 511
Address Box 506 Liberal, Kansas 67901

STATE OF Colorado COUNTY OF El Paso ss.
JACK ZIMMERMAN (employee of owner) or (owner or operator) of the above-described well, being first duly sworn on oath, says: That I have knowledge of the facts, statements, and matters herein contained and the log of the above-described well as filed and that the same are true and correct. So help me God.

(Signature) _____

Subscribed and sworn to before me this 9th day of Jan 1976

My commission expires April 12, 1977
Lois D. Jackson Notary Public.

15-097-10206-0000

T. G. WRIGHT
CONSULTING GEOLOGIST
805 WICHITA PLAZA
WICHITA, KANSAS 67202

June 29, 1966

Re: GEOLOGICAL WELL REPORT

William Gruenerwald & Associates, Inc.
#1 Effie Price
C NW NE Section 4-T28S-R20W
Fralick West Pool, Kiowa County, Kansas
Contractor: Walters Drilling Company
Spud: May 24, 1966
8-5/8" surface casing @ 570'
4-1/2" production casing @ 5024'
Rotary Completion: June 21, 1966
Total Depth: 5025 (Rotary) 5027 (Elec.)

William Gruenerwald & Associates, Inc.
P. O. Box 909
Colorado Springs, Colorado

Gentlemen:

Listed below are the pertinent geological tops, an evaluation of the porosities encountered, a record of all tests taken and a lithologic description of Diamond Core taken in the Mississippian Limestone. Samples were examined from 4100-5025' TD. The hole was logged electrically before being cased, that data included herein.

Enclosed herewith is a copy of the plotted drilling time which includes lithology and other pertinent data.

Electric Log Tops

Elevation:	2310 KB
HEEBNER SHALE	4128 (-1818)
BROWN LIME	4278 (-1968)
LANSING-KANSAS CITY	4288 (-1978)
4291-95	(Rotary Measurement) Limestone, buff, oolitic, good porosity, no show.
BASE OF KANSAS CITY	4688 (-2378)
CHEROKEE	4806 (-2496)
MISSISSIPPIAN LIMESTONE	4903 (-2593)
(See core description below)	

RECEIVED
STATE CORPORATION COMMISSION

AUG 25 1975

CONSERVATION DIVISION
Wichita, Kansas