


STATE OF KANSAS
STATE CORPORATION COMMISSION

WELL PLUGGING RECORD

Give All Information Completely
Make Required Affidavit
Mail or Deliver Report to:
Conservation Division
State Corporation Commission
211 No. Broadway
Wichita, Kansas

Kingman County. Sec. 8 Twp. 27 Rge. 9 (E) W (W)

NORTH

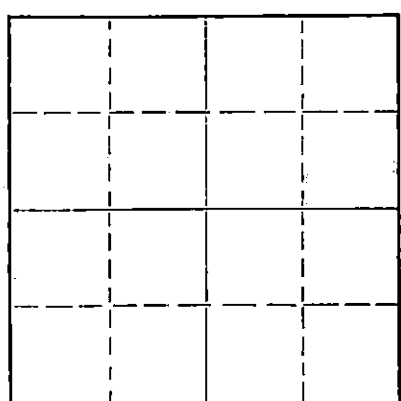

Locate well correctly on above
Section Plat

Location as "NE/CNW%SW%" or footage from lines SE SE NW
Lease Owner L. C. Smitherman
Lease Name Sales Well No. 1
Office Address P. O. Box 627, Augusta, Kansas
Character of Well (completed as Oil, Gas or Dry Hole) Dry Hole
Date well completed March 21 1959
Application for plugging filed March 21 1959
Application for plugging approved March 21 1959
Plugging commenced March 21 1959
Plugging completed March 21 1959
Reason for abandonment of well or producing formation Dry hole

If a producing well is abandoned, date of last production 19
Was permission obtained from the Conservation Division or its agents before plugging was commenced? Yes

Name of Conservation Agent who supervised plugging of this well Frank Broadfoot
Producing formation None Depth to top Bottom Total Depth of Well 4300 Feet
Show depth and thickness of all water, oil and gas formations.

OIL, GAS OR WATER RECORDS

CASING RECORD

FORMATION	CONTENT	FROM	TO	SIZE	PUT IN	PULLED OUT
		0	298	8 5/8"	298'	None

Describe in detail the manner in which the well was plugged, indicating where the mud fluid was placed and the method or methods used in introducing it into the hole. If cement or other plugs were used, state the character of same and depth placed, from feet to feet for each plug set.
Set bottom plug at 275' cemented with 15 sacks of cement, set top plug at 40' cemented with 10 sacks cement. Cut surface pipe off 2' below ground level and welded cap on.

RECEIVED
STATE CORPORATION COMMISSION

MAR 24 1959

CONSERVATION DIVISION
Wichita, Kansas

3-24-59

(If additional description is necessary, use BACK of this sheet)

Name of Plugging Contractor L. C. Smitherman
Address P. O. Box 627 Augusta, Kansas

STATE OF Kansas, COUNTY OF Butler, ss.
L. C. Smitherman (employee of owner) or (owner or operator) of the above-described well, being first duly sworn on oath, says: That I have knowledge of the facts, statements, and matters herein contained and the log of the above-described well as filed and that the same are true and correct. So help me God.

(Signature) L. C. Smitherman
P. O. Box 627, Augusta, Kansas
(Address)

SUBSCRIBED AND SWORN TO before me this 23rd. day of March, 19 59

My commission expires March 31, 1962

Carl J. Lehr Notary Public.

PLUGGING
FILE SEC. 8 T. 29 R. 9 W
BOOK PAGE 25 LINE 17

SALES #1

Company: L. C. Smitherman - Oil Producer
 Contractor: L. C. Smitherman Drilling Company
 Commenced: March 3, 1959
 Completed: March 21, 1959

Location: SE SE NW, Sec. 8-27S-9W,
 Kingman County, Kansas.
 Elevation: 1739. DF
 Casing: 298" - 8 5/8", cemented w/
 275 sacks.

FIGURES INDICATE BOTTOMS OF FORMATIONS:

0	90	Sand
90	200	Shale & Lime
200	298	Shale & Shells
298	780	Shale
780	1146	Shale & Lime
1146	1340	Lime & Shale
1340	1430	Lime
1430	1565	Lime
1565	1655	Lime
1655	1805	Lime
1805	1970	Lime
1970	2105	Lime & Shale
2105	2222	Lime & Shale
2222	2425	Shale & Shells
2425	2540	Shale & Shells
2540	2580	Lime & Shale
2580	2615	Shale & Lime Streaks
2615	2710	Lime & Shale
2710	2930	Shale & Shells
2930	3050	Lime & Shale
3050	3145	Lime & Shale
3145	3258	Shale & Shells
3258	3368	Lime Shale
3368	3472	Shale & Lime
3472	3532	Shale & Shells
3532	3586	Lime
3586	3666	Lime
3666	3708	Lime
3708	3772	Lime
3772	3867	Lime & Shale
3867	3944	Shale & Shells
3944	3990	Lime & Shale
3990	3995	Mississippi Lime
3995	4036	Lime
4036	4047	Lime
4047	4075	Lime
4075	4117	Lime & Shale
4117	4179	Shale
4179	4232	Shale & Lime
4232	4252	Shale
4252	4268	Lime
4268	4300	Lime
4300		TOTAL DEPTH

RECEIVED
 STATE CORPORATION COMMISSION
 MAR 24 1959
 CONSERVATION DIVISION

This is to certify the above and foregoing to be a true and correct copy of the log on the Sales #1, located in the SE SE NW, Section 8-27S-9W, Kingman County, Kansas.

L. C. SMITHERMAN DRILLING COMPANY

BY: *[Signature]*
 L. C. Smitherman

Subscribed and sworn to before me this 23rd day of March, 1959.

[Signature]
 Carl J. Lehr, Notary Public

My commission expires March 31, 1962.

PLUGGING
 FILE SEC 8 T29 R9W
 BOOK PAGE 25 LINE 17