

STATE OF KANSAS  
STATE CORPORATION COMMISSION


WELL PLUGGING RECORD

Give All Information Completely  
Make Required Affidavit  
Mail or Deliver Report to:  
Conservation Division  
State Corporation Commission  
211 No. Broadway  
Wichita, Kansas

Kingman County, Sec. 36 Twp. 27S Rge. 7 (E) W (W)

Location as "NE/CNW%SW%" or footage from lines NW SW  
Lease Owner Bachus Oil Company  
Lease Name Meade Well No. 1  
Office Address 721 E. Central, Wichita, Kansas  
Character of Well (completed as Oil, Gas or Dry Hole) Dry  
Date well completed 11-6-19 63  
Application for plugging filed 11-6-19 63  
Application for plugging approved 11-6-19 63  
Plugging commenced 11-6-19 63  
Plugging completed 11:00 PM 11-6-19 63  
Reason for abandonment of well or producing formation D & A

NORTH

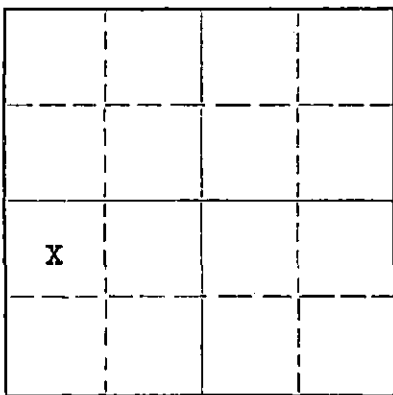

Locate well correctly on above  
Section Plat

If a producing well is abandoned, date of last production 19  
Was permission obtained from the Conservation Division or its agents before plugging was commenced? Yes

Name of Conservation Agent who supervised plugging of this well Archie V. Elving  
Producing formation \_\_\_\_\_ Depth to top \_\_\_\_\_ Bottom \_\_\_\_\_ Total Depth of Well \_\_\_\_\_ Feet  
Show depth and thickness of all water, oil and gas formations.

OIL, GAS OR WATER RECORDS

CASING RECORD

FORMATION	CONTENT	FROM	TO	SIZE	PUT IN	PULLED OUT
				8 5/8	214	-0-

Describe in detail the manner in which the well was plugged, indicating where the mud fluid was placed and the method or methods used in introducing it into the hole. If cement or other plugs were used, state the character of same and depth placed, from \_\_\_\_\_ feet to \_\_\_\_\_ feet for each plug set.

Filled from 4308 to 200' with heavy mud  
Plug No. 1 at 200' with 1/2 sack hulls and 25 sacks cement  
Filled with heavy mud from 200' to 40'  
Plug No. 2 from 40' to surface with 1/2 sack hulls and 10 sacks cement  
Plugged rathole with 2 sacks cement

RECEIVED  
STATE CORPORATION COMMISSION

NOV 15 1963

11-15-63

CONSERVATION DIVISION  
Wichita, Kansas

(If additional description is necessary, use BACK of this sheet)

Name of Plugging Contractor Bachus Oil Company  
Address 721 E. Central - Wichita, Kansas

STATE OF Kansas COUNTY OF Sedgwick, ss.  
Nelson R. Thomas

(employee of owner) or (owner or operator) of the above-described well, being first duly sworn on oath, says: That I have knowledge of the facts, statements, and matters herein contained and the log of the above-described well as filed and that the same are true and correct. So help me God.

(Signature) Nelson R. Thomas  
721 E. Central, Wichita, Kansas  
(Address)

SUBSCRIBED AND SWORN TO before me this 14th day of November, 19 63

My commission expires October 14, 1964

Lovene C. Ehram  
Lovene C. Ehram Notary Public.



MEADE NO. 1

Casing Record:

8 5/8 at 214  
w 225 sacks cement  
2% Calcium Chloride

Operator: Bachus Oil Company

Contractor: Bachus Oil Company

Commenced: 10-22-63

Completed: 11-6-63

Location: NW SW  
Sec. 36-27S-7W  
Kingman County,  
Kansas

Elevation: 1569 KB  
1564 GL

Production: D & A

Formation:

From	To	
0	25	Surface Sand
25	140	Red Bed & Shells
140	214	Shale, Red Bed & Shells
214	568	Red Bed
568	1040	Shale & Shells
1040	1250	Shells & Lime
1250	1339	Shale & Lime
1339	1611	Lime
1611	2022	Shale & Lime
2022	2374	Lime, Sand & Shale
2374	2951	Lime & Shale
2951	3185	Lime & Sand
3185	3661	Lime
3661	3715	Lime with Shale
3715	3909	Lime & Shale
3909	3994	Miss Chat
3994	4174	Lime
4174	4264	Shale
4264	4280	Shaley Dolomite
4280	4289	Dolomite
4289	4308	Sand
	4308	Total Depth

Formation Tops:

Heebner	2926	(-1357)
Toronto	2938	(-1369)
Douglas	2953	(-1384)
Brown Lime	3169	(-1600)
Lansing	3182	(-1613)
Mississippian	3910	(-2341)
Kinderhook	4174	(-2605)
Simpson Dolomite	4280	(-2711)
Simpson Sand	4289	(-2720)
Total Depth	4308	(-2739)

RECEIVED  
STATE CORPORATION COMMISSION

NOV 15 1963

CONSERVATION DIVISION  
Wichita, Kansas

DST No. 1 1292-1312  
Open 1 Hour  
F.B. Dec at end of test  
Rec. 80' mud  
FP 31-62  
BHP 229/30 167/30  
HH 699-699  
T 88°

DST No. 4 3910-3922  
F.B. Throughout test Open 1 Hour  
G.T.S. 4 min T.S.T.M  
Rec. 100' G.C.M. with few oil  
spots  
FP 22-40  
BHP 1379/30 1296/30  
T 127°

DST No. 2 1988-2022  
Open 1 Hour  
F.B. throughout test  
Rec. 930 Salt water  
FP 84-490  
BHP 807/30 776/30  
T 93°

DST No. 5 3924- 3942  
Open 2 hours  
F.B. Throughout test  
Rec. 120' mud plus  
480' salt water  
FP 31-308  
BHP 1452/30 1280/30  
T 129°

DST No. 3 2937-2951  
Open 1 Hour  
Rec. 5' mud  
FP 31-31  
BHP 31/30 31/30  
T 99°

I hereby certify that this is a true and correct copy of  
the above log to the best of my knowledge.

Nelson R. Thomas  
Nelson R. Thomas

Subscribed and sworn to before me

This 17th day of November, 1963

My Commission expires October 14, 1964

Lovene C. Ehrsam  
Lovene C. Ehrsam, Notary Public