

STATE OF KANSAS  
STATE CORPORATION COMMISSION


Form CP-4

Give All Information Completely  
Make Required Affidavit.  
Mail or Deliver Report to:  
Conservation Division  
State Corporation Commission  
212 No. Market  
Wichita, Kansas

WELL PLUGGING RECORD

Kingman County. Sec. 35 Twp. 27S Rge. 7 XXX (w) West  
Location as "NE/CNW%SW%" or footage from lines 150' West of C NE NE  
Lease Owner MACK OIL CO.  
Lease Name McKenna Well No. 3  
Office Address 812 Union Center Bldg., Wichita, Kansas 67202  
Character of Well (completed as Oil, Gas or Dry Hole) Dry Hole  
Date well completed October 9 1967  
Application for plugging filed October 10 1967  
Application for plugging approved October 10 1967  
Plugging commenced October 10 1967  
Plugging completed October 10 1967  
Reason for abandonment of well or producing formation Dry

NORTH

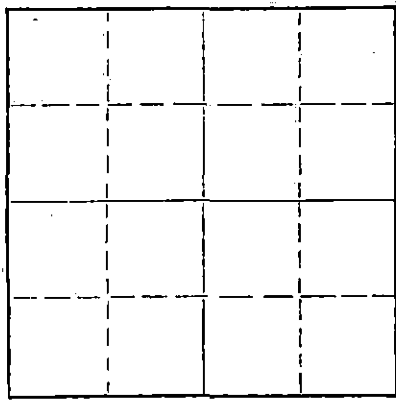

Locate well correctly on above  
Section Plat

If a producing well is abandoned, date of last production \_\_\_\_\_ 19\_\_\_\_  
Was permission obtained from the Conservation Division or its agents before plugging was commenced? Yes

Name of Conservation Agent who supervised plugging of this well Archie V. Elving, Pratt, Kansas  
Producing formation None Depth to top \_\_\_\_\_ Bottom \_\_\_\_\_ Total Depth of Well 3630 Feet  
Show depth and thickness of all water, oil and gas formations.

OIL, GAS OR WATER RECORDS

CASING RECORD

| FORMATION | CONTENT | FROM | TO | SIZE | PUT IN | PULLED OUT |
|-----------|---------|------|----|------|--------|------------|
|           |         |      |    |      |        |            |
|           |         |      |    |      |        |            |
Describe in detail the manner in which the well was plugged, indicating where the mud fluid was placed and the method or methods used in introducing it into the hole. If cement or other plugs were used, state the character of same and depth placed, from \_\_\_\_\_ feet to \_\_\_\_\_ feet for each plug set.

Plugged with 35 sax common cement @ 230'  
25 sax common cement @ 50'  
5 sax common cement in rathole  
Plug down @ 4:00 p.m., October 10, 1967

RECEIVED  
STATE CORPORATION COMMISSION  
OCT 13 1967

10-13-67  
CONSERVATION DIVISION  
Wichita, Kansas

(If additional description is necessary, use BACK of this sheet)

Name of Plugging Contractor MACK OIL CO.  
Address P. O. Box 400, Duncan, Oklahoma 73533

STATE OF KANSAS, COUNTY OF SEDGWICK, ss.  
Robert L. Harris (employee of owner) or (owner or operator) of the above-described well, being first duly sworn on oath, says: That I have knowledge of the facts/statements, and matters herein contained and the log of the above-described well as filed and that the same are true and correct. So help me God.  
(Signature) Robert L. Harris

812 Union Center Bldg., Wichita, Kansas 67202  
(Address)

SUBSCRIBED AND SWORN TO before me this 12th day of October 1967

My commission expires September 21, 1968

Elizabeth F. Nice  
Elizabeth F. Nice  
Notary Public.

MACK OIL CO.

DUNCAN, OKLAHOMA  
73533

DRILLERS WELL LOG

#3 McKenna

150' West of C NE NE  
Section 35-27S-7W  
Kingman County, Kansas  
Elevation: 1581' Kelly Bushing  
Initial Production: Dry  
Contractor: Mack Oil Co.

Commenced R. D.: 10-3-67

Completed R. D.: 10-9-67

Rotary Total Depth: 3630'

| <u>STRATA</u>   | <u>DEPTH</u>            |
|-----------------|-------------------------|
| Sand & Shale    | 0 - 145'                |
| Shale           | 145 - 260               |
| Red Bed & Shale | 260 - 400               |
| Shale           | 400 - 912               |
| Lime & Shale    | 912 - 1640              |
| Shale & Shells  | 1640 - 2026             |
| Lime & Shale    | 2026 - 2370             |
| Shale & Lime    | 2370 - 2640             |
| Lime            | 2640 - 2676             |
| Lime & Shale    | 2676 - 2950             |
| Shale & Lime    | 2950 - 3275             |
| Lime            | 3275 - 3630' - R. T. D. |

RECEIVED  
STATE COMMISSIONER OF CONSERVATION

OCT 13 1967

CONSERVATION DIVISION  
Wichita, Kansas

I hereby certify that the above is a true and correct log of said well as reflected by the daily drilling reports.

MACK OIL CO.

By Robert L. Harris  
Robert L. Harris

Signed and sworn to in my presence this 10th day of October, 1967,  
by Robert L. Harris, representative of Mack Oil Co.

Elizabeth F. Nice  
Elizabeth F. Nice, Notary Public

My commission expires September 21, 1968