


STATE OF KANSAS
STATE CORPORATION COMMISSION

Give All Information Completely
Make Required Affidavit
Mail or Deliver Report to:
Conservation Division
State Corporation Commission
211 No. Broadway
Wichita, Kansas

WELL PLUGGING RECORD

NORTH

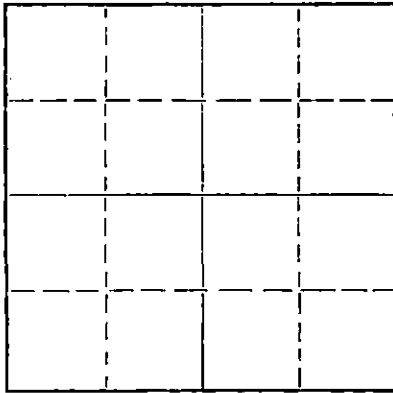

Locate well correctly on above
Section Plat

Kingman County. Sec. 35 Twp. 27S Rge. (E) 7 (W)
Location as "NE/CNW/SW" or footage from lines SE-SW
Lease Owner Anschutz Drilling Company
Lease Name Dondlinger Well No. 1
Office Address 1019 Central Building, Wichita 2, Kansas
Character of Well (completed as Oil, Gas or Dry Hole) Dry hole
Date well completed 9-28-1956
Application for plugging filed 10-1-1956
Application for plugging approved 10-2-1956
Plugging commenced 10-8-1956
Plugging completed 10-12-1956
Reason for abandonment of well or producing formation Dry hole

If a producing well is abandoned, date of last production 19
Was permission obtained from the Conservation Division or its agents before plugging was commenced? Yes

Name of Conservation Agent who supervised plugging of this well M. A. Rives
Producing formation Lansing, Kansas City Depth to top Bottom 3563 1/2' PB Total Depth of Well 4395 Feet
Show depth and thickness of all water, oil and gas formations.

OIL, GAS OR WATER RECORDS

CASING RECORD

FORMATION	CONTENT	FROM	TO	SIZE	PUT IN	PULLED OUT
Lansing, Kansas City	Water			8 5/8"	184'	None
				5 1/2"	3909'	2835'

Describe in detail the manner in which the well was plugged, indicating where the mud fluid was placed and the method or methods used in introducing it into the hole. If cement or other plugs were used, state the character of same and depth placed, from _____ feet to _____ feet for each plug set.

Plugged back with sand to 3500'.
Dumped 5 sacks of cement with dump bailer.
Pulled pipe up to 1800'.
Pumped 60 sacks of mud down casing with Globe Cementing Company.
Completed pulling pipe.
Mudded hole to 180'.
Set 10' rock bridge.
Dumped 20 sacks of cement.
Mudded hole to 35'.
Set rock bridge.
Dumped 10 sacks of cement to top of surface pipe.

(If additional description is necessary, use BACK of this sheet)

Name of Plugging Contractor E & L Casing Pulling Company
Address Great Bend, Kansas

STATE OF KANSAS, COUNTY OF SEDGWICK, ss.
John W. Ritchey (employee of owner) or (owner or operator) of the above-described

well, being first duly sworn on oath, says: That I have knowledge of the facts, statements, and matters herein contained and the log of the above-described well as filed and that the same are true and correct. So help me God.

(Signature)

(Address)

SUBSCRIBED AND SWORN to before me this 31st day of October, 1956

My commission expires April 23, 1958

RECEIVED
STATE CORPORATION COMMISSION
NOV - 2 1956
CONSERVATION DIVISION
Wichita, Kansas

PLUGGING
FILE SEC. 25 T. 27 R. 7W
BOOK PAGE 104 LINE 10

Notary Public.

ROTARY DRILLING LOG

OPERATOR: Fred B. Anschatz
Dandolinger #1
SE SE SW Sec. 35-27-7W,
Kingman County, Kansas

CONTRACTOR: Prime Drilling Company
COMM: 4/6/56
COMP: 5/1/56

Formations:

Red Bed, Red Rock & Shale	184'
Red Rock Green Shale	390'
Shale (Gray) & Lime & Shells	770'
Shale & Shells	960'
Lime & Shale	1050'
Brown Lime & Shale	1165'
Shale & Lime	1880'
Lime	1950'
Shale w/ Lime strks.	2070'
Shale & Lime	2265'
Shale w/ Lime strks.	2295'
Lime	2325'
Lime & Shale	2345'
Shale w/Lime strks.	2600'
Lime	2660'
Shale w/Lime strks.	2688'
Lime	2760'
Lime & Shale	2965'
Lime	3035'
Sand & Shale	3115'
Lime	3604'
Lime & Shale	3715'
Lime	3760'
Lime & Shale	3868'
Misc.	3882'
Lime Chert	3892'
Cherty Lime	3980'
Chert & Dolomite	4010'
Lime	4118'
Shale	4210'
Lime	4232'
Shale Sand & Lime	4247'
Sand & Shale	4279'
Lime	4315'
Shale Sandy	4370'
Rotary Total Depth	4395'

Remarks: Set 8-5/8" surface casing
at 185' cemented with 175 sacks Pozmix,
2% C. C.

Set 5-1/2" production string at 3908'
cemented with 150 sacks cement.

We certify the above log is true and
correct to the best of our knowledge
and belief.

PRIME DRILLING COMPANY

R. R. McMicel
R. R. McMicel

RECEIVED

NOV - 1 1956

PETROLEUM MANAGEMENT, INC.

RECEIVED	PLUGGING
STATE CORPORATION COMMISSION	FILE SEC 35 T. 27 R. 7W
NOV 2 1956	BOOK PAGE 104 LINE 10
CONSERVATION DIVISION	
Wichita, Kansas	