

STATE OF KANSAS  
STATE CORPORATION COMMISSION


WELL PLUGGING RECORD

Give All Information Completely  
Make Required Affidavit  
Mail or Deliver Report to:  
Conservation Division,  
State Corporation Commission,  
800 Bittling Building,  
Wichita, Kansas.

FORMATION PLUGGING RECORD

Strike out upper line  
when reporting plugging  
off formations.

NORTH

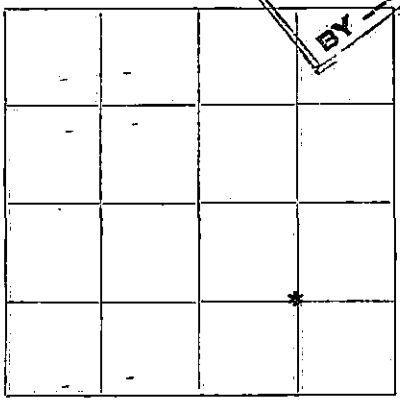

Locate well correctly on above  
640 A. Plat

RECEIVED  
JUL 16 1936  
BY *NA 7-10-36*

Kingman County. Sec. 18 Twp. 27S Rge. (E) 8 (W)

Lease Name C. M. Prather  
Lease Owner Olson Oil Company  
Office Address Box 598, Tulsa, Oklahoma  
Character of Well (Oil, Gas or Dry) Dry Total Depth of Well 4535 Feet  
Date, well, completed July 3 1936  
Application for plugging and log of well filed July 3 1936  
Application for plugging approved July 3 1936  
Plugging Commenced July 3 1936  
Plugging Completed July 3 1936  
Reason for abandonment of well or producing formation Non-productive

If a producing well is abandoned, date of last production 1936  
Was permission obtained from the Conservation Commission or its agents before plugging was commenced? Yes

Name of Conservation Officer who supervised plugging of this well \_\_\_\_\_  
Producing formation \_\_\_\_\_ Depth to top \_\_\_\_\_ Bottom \_\_\_\_\_

Show depth and thickness of all water, oil and gas formations.

OIL, GAS OR WATER RECORDS

CASING RECORD

Formation	Content	From	To	Size	Put In	Pulled Out
Lansing	Dry	3400	3839	15 1/2"	187'	None
Kinderhook	"	4141	4339			
Viola	"	4339	4394			
Simpson	"	4394	4516			
Siliceous	"	4516	4535			
Miss.	"	4039	4141			

Describe in detail the manner in which the well was plugged, indicating where the mud fluid was placed and the method or methods used in introducing it into the hole. If cement or other plugs were used, state the character of same and depth placed, from \_\_\_\_\_ feet to \_\_\_\_\_ feet for each plug set.

Pumped hole full of heavy mud. Put bridge in 16 feet below base of cellar and dumped 20 sacks of cement.

PLUGGING  
FILE SEC 18-27-8W  
BOOK PAGE 52 LINE 7

(If additional description is necessary use BACK of this sheet)

Does the above conform strictly to the Conservation Division regulations? Yes  
Was exception made? \_\_\_\_\_ If so describe \_\_\_\_\_  
Correspondence regarding this well should be addressed to Olson Oil Company  
Address Box 408, Burton, Kansas

STATE OF Kansas COUNTY OF Renov., ss.  
C. L. Barrett (employee of owner) or (owner or operator) of the above-described well,  
being first duly sworn on oath, says: That I have knowledge of the facts, statements, and matters herein contained and the log of the above-described well as filed and that the same are true and correct. So help me God!

(Signature) C. L. Barrett  
Box 408 Burton Kansas (Address)

SUBSCRIBED AND SWORN TO before me this 8 day of July, 1936

My commission expires 4-20-38  
G. F. Bryant Notary Public.

OLSON OIL COMPANY  
 C. M. PRATHER # 1  
 C SE Sec. 18-27S-8W  
 KINGMAN COUNTY, KANSAS

COMMENCED 5-15-36  
 COMPLETED 7-3-36  
 Dry

CASING RECORD

0					
40	Surface	4141	Chert, hard	15½"	70# 187'
92	Clay & shells	4219	Shale & shells		
174	Shale & lime shells	22	Shale		
186	Shale	79	Shale & shells		
316	Red shale & shells	81	Lime		
478	" " "	86	Shale		
609	Shale & shells	93	Lime		
716	Red shale	4308	Shale		
1190	Shale & shells	15	Lime		
1256	Shale	41	Lime & shale		
1310	Shale & shells	4339	Lime, Viola		
14	Broken lime	52	Lime		
1952	Lime	4429	Lime		
2026	Broken lime	34	Broken lime		
2194	Lime	77	Lime		
2264	Lime	4497	Shale		
2381	Broken lime	4506	Shale		
2427	Lime	4535	Lime		
38	Broken lime		Total Depth		
73	Lime				
2550	Broken lime				
2722	Lime				
59	Lime				
2812	Broken lime				
79	Lime, hard				
2927	Broken lime				
3028	Lime				
65	Broken lime				
3275	Lime				
3303	Shale & shells				
12	Broken lime				
34	Lime, show of oil				
3375	Lime				
3405	Broken lime				
3598	Lime				
3738	Lime, hard				
87	Broken lime				
3889	Lime				
3908	Broken lime				
24	Lime				
35	"				
55	Broken lime				
76	Lime				
93	Broken lime				
4021	Lime				
39	Shale, variegated				
46	Chat				
89	Lime, Miss.				
4113	Lime				

**PLUGGING**  
 FILE SEC. 18-27-8W  
 BOOK PAGE 52 LINE 7