

STATE OF KANSAS  
STATE CORPORATION COMMISSION


WELL PLUGGING RECORD

Give All Information Completely  
Make Required Affidavit  
Mail or Deliver Report to:  
Conservation Division  
State Corporation Commission  
800 Bittling Building  
Wichita, Kansas

OR  
FORMATION PLUGGING RECORD

Strike out upper line  
when reporting plug-  
ging of formations.

NORTH

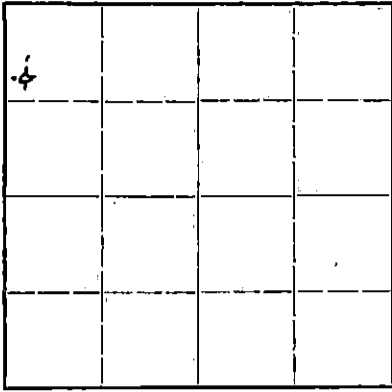

Locate well correctly on above  
Section Plat

Kingman County. Sec. 35 Twp 27 Rge. (E) 8 (W) 1  
Location as "NE $\frac{1}{4}$ NW $\frac{1}{4}$ SW $\frac{1}{4}$ " or footage from lines SW $\frac{1}{4}$  NW $\frac{1}{4}$  NW $\frac{1}{4}$   
Lease Owner A. G. Hill  
Lease Name A. E. Woolridge Well No. 1  
Office Address 700 Mercantile Bank Dallas, Texas  
Character of Well (completed as Oil, Gas or Dry Hole) Dry Hole  
Date well completed 12-18-46 1947  
Application for plugging filed 4-19 1947  
Application for plugging approved 1947  
Plugging commenced 12-18 1946  
Plugging completed 12-18 1946  
Reason for abandonment of well or producing formation Dry Hole

If a producing well is abandoned, date of last production 1947  
Was permission obtained from the Conservation Division or its agents before plugging was com-  
menced? Yes - by Harbar Drilling Co.

Name of Conservation Agent who supervised plugging of this well  
Producing formation None Depth to top Bottom Total Depth of Well Feet  
Show depth and thickness of all water, oil and gas formations.

OIL, GAS OR WATER RECORDS

CASING RECORD

Formation	Content	From	To	Size	Put In	Pulled Out
<u>Kansas City</u>	<u>Water</u>	<u>3320</u>	<u>3925</u>	<u>10<math>\frac{3}{4}</math>"</u>	<u>238'</u>	<u>None</u>
<u>Chat</u>	<u>"</u>	<u>3925</u>	<u>4147</u>			
<u>Viola</u>	<u>"</u>	<u>4242</u>	<u>4255</u>			
<u>Simpson</u>	<u>"</u>	<u>4328</u>	<u>4408</u>			
<u>Arbuckle</u>	<u>"</u>	<u>4466</u>	<u>4534</u>			

Describe in detail the manner in which the well was plugged, indicating where the mud fluid was placed and the method or methods used in introducing it into the hole. If cement or other plugs were used, state the character of same and depth placed, from feet to feet for each plug set.

Hole filled with rotary mud prior to cementing.  
Placed cement plug 180' to 220' (20 sacks)  
" " " 0' " 10' (5 " )

(If additional description is necessary, use BACK of this sheet)

Correspondence regarding this well should be addressed to A. G. Hill  
Address 700 Mercantile Bank Bldg.  
Dallas, Texas

STATE OF \_\_\_\_\_, COUNTY OF \_\_\_\_\_, ss.  
\_\_\_\_\_  
(employee of owner) or (owner or operator) of the above-described well,  
being first duly sworn on oath, says: That I have knowledge of the facts, statements, and matters herein contained and the log of the above-described well as filed and that the same are true and correct. So help me God.

(Signature) L. A. Gilles  
912 Peoples Bank - Tyler, Texas  
(Address)

SUBSCRIBED AND SWORN to before me this 19<sup>th</sup> day of April, 1947  
Helen Curtis  
Notary Public.

My commission expires 6/1/47

PLUGGING  
FILE SEC 35 T 27 R 8W  
BOOK PAGE 88 LINE 14

