


WELL PLUGGING RECORD

STATE OF KANSAS  
STATE CORPORATION COMMISSION

Give All Information Completely  
Make Required Affidavit  
Mail or Deliver Report to:  
Conservation Division  
State Corporation Commission  
212 No. Market  
Wichita, Kansas

NORTH

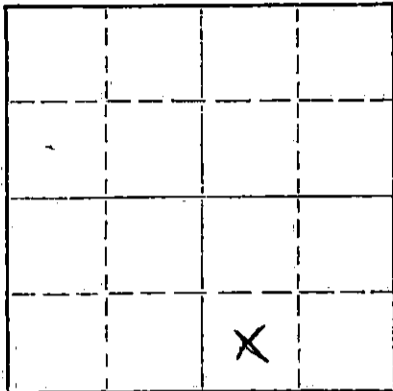

Locate well correctly on above  
Section Plat

Kiowa County, Sec. 33 Twp. 27S Rge. 16 (E) W (W)  
Location as "NE/CNW/SW" or footage from lines C SW SE  
Lease Owner Rosen Oil Company  
Lease Name Fankhauser Well No. #1  
Office Address 260 Sutton Place Wichita, Kansas  
Character of Well (completed as Oil, Gas or Dry Hole) Oil  
Date well completed \_\_\_\_\_ 19\_\_\_\_  
Application for plugging filed May 16 19 69  
Application for plugging approved May 19 19 69  
Plugging commenced May 18 19 69  
Plugging completed: 4:30 P. M. May 22 19 69  
Reason for abandonment of well or producing formation \_\_\_\_\_

If a producing well is abandoned, date of last production \_\_\_\_\_ 19\_\_\_\_  
Was permission obtained from the Conservation Division or its agents before plugging was commenced? Yes

Name of Conservation Agent who supervised plugging of this well Ralph Warren  
Producing formation \_\_\_\_\_ Depth to top \_\_\_\_\_ Bottom \_\_\_\_\_ Total Depth of Well \_\_\_\_\_ Feet  
Show depth and thickness of all water, oil and gas formations.

OIL, GAS OR WATER RECORDS

CASING RECORD

FORMATION	CONTENT	FROM	TO	SIZE	PUT IN	PULLED OUT
				10 3/4	381	None
				4 1/2	4721	2619

Describe in detail the manner in which the well was plugged, indicating where the mud fluid was placed and the method or methods used in introducing it into the hole. If cement or other plugs were used, state the character of same and depth placed, from \_\_\_\_\_ feet to \_\_\_\_\_ feet for each plug set.

5 - 18 - 69 Dumped sand to 4600'. Mixed and dumped 4 sx of cement from 4600' to 4550'.  
5 - 22 - 69 Set 10' rock bridge from 250' to 240'. Mixed and dumped 40 sx of cement from 240' to 160'. Mudded casing from 160' to 40'. Set 10' rock bridge from 40' to 30'. Mixed and dumped 15 sx of cement from 30' to base of cellar.

Completed job at 4:30 P. M.

RECEIVED  
STATE CORPORATION COMMISSION  
JUN 4 1969  
CONSERVATION DIVISION  
Wichita, Kansas

(If additional description is necessary, use BACK of this sheet)

Name of Plugging Contractor Russ Casing Pulling, Inc.  
Address P. O. Box 1082 Great Bend, Kansas 67530

STATE OF KANSAS, COUNTY OF SEDGWICK, ss.  
Carroll F. Mahoney (owner or operator) of the above-described well, being first duly sworn on oath, says: That I have knowledge of the facts, statements, and matters herein contained and the log of the above-described well as filed and that the same are true and correct. So help me God.

(Signature) Carroll F. Mahoney  
Rosen Oil Company, 260 Sutton Place Wichita, Kan.  
(Address)

SUBSCRIBED AND SWORN to before me this 4th day of June, 19 69

My commission expires March 19, 1973

Mary Hammond  
Mary Hammond, Notary Public.

PHILLIPS PETROLEUM CO. - Operator

SINTRA PETROLEUM CO., INC - Contr.

WELL NUMBER #1  
C SW SE  
Sec. 33-27E-10N  
Kiowa County, Kansas

T. D.: 4730'

Commenced: 12-2-61  
Completed: 12-22-61

Casings:

10-3/4" Set at 32.75' Set at 381' K.B.  
4-1/2" Set at 4721'

Cement:

with 160 gr. cement  
with 60 gr. cement

FORMATION

DEPTH

Clay & Sand	210
Shale & Shells	310
Shale	381
Lime	420
Shale, Shells & Red Bed	500
Shale	1040
Sand	1070
Shale & Shells	1200
Salt & Shale	1430
Shale & Shells	2070
Shale & Lime	2190
Lime	2370
Lime & Shale	2475
Lime	2510
Lime & Shale	2637
Lime	2760
Shale & Lime	3110
Lime	3235
Shale & Lime	3365
Lime	3525
Lime & Shale	3607
Lime	3960
Lime & Shale	4200
Lime	4556
Shale & Lime	4606
Lime	4642
Lime & Shale	4651
Shale & Sand	4661
Sandy Shale & Red Shale	4697
Mississippi Lime	4707
Shale & Chert	4730

RECEIVED  
STATE CORPORATION COMMISSION  
MAY 19 1969  
CONSERVATION DIVISION  
Wichita, Kansas

STATE OF KANSAS }  
COUNTY OF RUSSELL } 681

I hereby certify that the above information is true  
and correct to the best of my knowledge.

C.T. Honaker

Subscribed and sworn to before me this 27th day of December,  
1961.

Larry Dietz  
Notary Public

My comm. expires: 10-17-63