

STATE OF KANSAS
STATE CORPORATION COMMISSION

WELL PLUGGING RECORD

Give All Information Completely
Make Required Affidavit
Mail or Deliver Report to:
Conservation Division
State Corporation Commission
800 Bitting Building
Wichita, Kansas

Kiowa County, Sec. 25 Twp. 27S Rge. 16 (W)

Location as "NE/CNW/SW" or footage from lines SW SW NW

Lease Owner Aurora Gasoline Co. and Anschutz Drilling Co.

Lease Name Clarkson Well No. 1

Office Address Union National Bank Bldg., Wichita, Kansas

Character of Well (completed as Oil, Gas or Dry Hole) Dry

Date well completed September 10 19 54

Application for plugging filed September 14 19 54

Application for plugging approved September 14 19 54


Plugging commenced September 17 19 54

Plugging completed September 22 19 54

Reason for abandonment of well or producing formation Noncommercial

If a producing well is abandoned, date of last production - 19

Was permission obtained from the Conservation Division or its agents before plugging was commenced? Yes

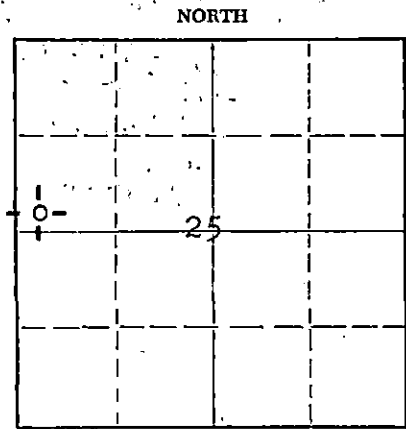

Locate well correctly on above Section Plat

Name of Conservation Agent who supervised plugging of this well M. A. Rives

Producing formation Cherokee Depth to top 4565 Bottom 4571 Total Depth of Well 4950 Feet

Show depth and thickness of all water, oil and gas formations.

OIL, GAS OR WATER RECORDS

CASING RECORD

FORMATION	CONTENT	FROM	TO	SIZE	PUT IN	PULLED OUT
				8 5/8"	902	None
				5 1/2"	4720	3895

Describe in detail the manner in which the well was plugged, indicating where the mud fluid was placed and the method or methods used in introducing it into the hole. If cement or other plugs were used, state the character of same and depth placed, from feet to feet for each plug set.

Cement plug 4720 ft. to 4695 ft.
Plugged back with crushed rock 4695 ft. to 4550 ft.
Set 5-sack cement plug at 4550 ft.
Circulated mud, including 30 sacks gel. Bailed down to 300 ft.
Set crushed rock bridge 300 ft to 295 ft.
Set 20-sack cement plug at 295 ft.
Plugged back with mud to 35 ft.
Set crushed rock bridge at 35 ft. to 30 ft.
Capped to surface with 10 sacks cement

(If additional description is necessary, use BACK of this sheet)

Name of Plugging Contractor Ace Pipe Pulling Company

Address Great Bend, Kansas

STATE OF KANSAS, COUNTY OF SEDGWICK, ss.
R. D. Reber (employee of owner) or (owner representative) of the above-described

well, being first duly sworn on oath, says: That I have knowledge of the facts, statements, and matters herein contained and the log of the above-described well as filed and that the same are true and correct. So help me God.

(Signature) R. D. Reber

810 Central Building, Wichita, Kansas (Address)

SUBSCRIBED AND SWORN to before me this 29th day of September, 19 54

My commission expires April 23, 1958


Marie C. Murphy Notary Public.

STATE CORPORATION COMMISSION

SEP 30 1954

CONSERVATION DIVISION
Wichita, Kansas

8-30-54

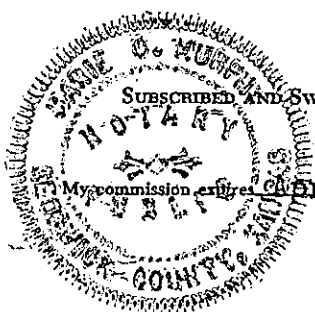

PLUGGING
FILE SEC 25 T 27S R 16W
BOOK PAGE 4 LINE 9

DRILLER'S LOG

Aurora & Anschutz
 #1 Clarkson
 SW SW NW 25-27-16W
 Kiowa County, Kansas

<u>TO</u>	<u>FROM</u>	
0	350	Surface Sand & Sandy Gravel
350	475	Red Rock
475	600	Sand
600	605	Sand & Red Rock
605	850	Shelly Red Rock
850	976	Red Rock
976	1020	Anhydrite
1020	1195	Shale
1195	1585	Shale & Shells
1585	1825	Salt, Shale & Lime
1825	2070	Shale & Shells
2070	2080	Shale
2080	2315	Lime
2315	2425	Lime & Shale
2425	2583	Lime
2583	2690	Lime & Shale
2690	2780	Shale & Lime
2780	3295	Lime & Shale
3295	3415	Shale
3415	3441	Lime
3441	3450	Shale & Lime
3450	3675	Lime & Shale
3675	3690	Gr. Sandy Lime
3690	3780	Lime & Shale
3780	3865	Shale & Lime
3865	4005	Lime
4005	4135	Shale & Lime
4135	4430	Lime
4430	4475	Lime & Shale
4475	4525	Lime
4525	4587	Lime & Shale
4587	4607	Shale, Sand & Lime
4607	4653	Miss. Lime
4653	4674	Sand
4674	4695	Shale & Lime
4695	4720	Shale
4720	4735	Lime & Shale
4735	4761	Shale & Lime
4761	4782	Lime & Shale
4782	4850	Lime
4850	4880	Lime & Shale
4880	4914	Shale, Chert & Lime
4914	4950	Arbuckle
4950	4950	ROTARY TOTAL DEPTH

COMMENCED: 8-7-54
 COMPLETED: 8-30-54

CASING RECORD:

Set 970' of 8 5/8" surface casing with 425 ex. cement.
 Set 5 1/2" casing at 4720' with 100 ex. cement.

CONSERVATION COMMISSION
 SEP 15 1954
 CONSERVATION DIVISION
 Wichita, Kansas

STATE OF KANSAS)
 COUNTY OF SEDGWICK) SS

I hereby affirm that the above and foregoing is a true and correct copy of the log of the #1 Clarkson located SW SW NW of Section 25-27-16W, Kiowa County, Kansas.

PLUGGING
 FILE SEC 25 T 27 R 16W
 BOOK PAGE 47 LINE 9

ANSCUTZ DRILLING CO., INC.

BY: *E. Hoelling*
 E. C. Koelling

Subscribed and sworn to before me this 1st day of September, 1954.

My Commission Expires: July 26, 1955.

Charlene Barbour
 Notary Public