


Give All Information Completely
Make Required Affidavit
Mail or Deliver Report to:
Conservation Division
State Corporation Commission
211 No. Broadway
Wichita, Kansas

WELL PLUGGING RECORD

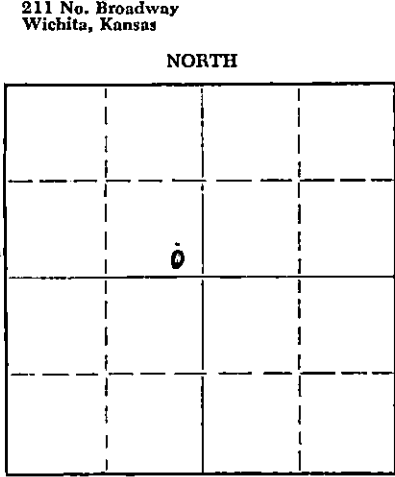

Locate well correctly on above Section Plat

Haskell County, Sec. 18 Twp. 28s Rge. 32W (E) SW NW
Location as "NE/CNW/SW" or footage from lines 100' N & 100' W of C of Section
Lease Owner ~~XXXXXXXXXX~~ National Associated Petroleum Company
Lease Name L. G. Mears Well No. 1
Office Address Fifth Floor Ritz Building, Tulsa, Oklahoma
Character of Well (completed as Oil, Gas or Dry Hole) Abandoned gas well
Date well completed December 26, 1950 1950
Application for plugging filed August 24, 1960 1960
Application for plugging approved August 24, 1960 1960
Plugging commenced August 28, 1960 1960
Plugging completed August 28, 1960 1960
Reason for abandonment of well or producing formation Water encroachment forced abandonment of well.
If a producing well is abandoned, date of last production September 1959
Was permission obtained from the Conservation Division or its agents before plugging was commenced? Yes

Name of Conservation Agent who supervised plugging of this well Frank Broadfoot, St. Johns, Kansas
Producing formation Krider & Winfield Depth to top 2671 Bottom 2755 Total Depth of Well 2755 Feet
Show depth and thickness of all water, oil and gas formations.

OIL, GAS OR WATER RECORDS

CASING RECORD

FORMATION	CONTENT	FROM	TO	SIZE	PUT IN	PULLED OUT
Krider	Gas	2671	2721	5 1/2"	2743	None
Winfield	Gas & Water	2743	2755	5 1/2"	2743	None

Describe in detail the manner in which the well was plugged, indicating where the mud fluid was placed and the method or methods used in introducing it into the hole. If cement or other plugs were used, state the character of same and depth placed, from _____ feet to _____ feet for each plug set.

Halliburton packer set @ 2652.
Spotted 30 sacks of cement on bottom. Cement from 2755 back to 2652.
Pulled ten joints of tubing & spotted heavy mud. Mud from 2652 to 2350.
Pulled fifty-four joints of tubing & spotted heavy mud. Mud from 2350 to 668.
Spotted 20 sacks of cement on bridge. Cement from 668 to 500.
Pulled remaining tubing & mixed heavy mud. Mud from 500 to 10.
Set bridge @ 10' cemented to surface. Cement from 10' to surface.

Remarks: The Halliburton packer was left in the hole @ 2652'.

STAMP: JAN 10 1961
CONSERVATION DIVISION
Wichita, Kansas
1-10-1961

(If additional description is necessary, use BACK of this sheet)

Name of Plugging Contractor Patrick Well Service
Address 1203 N. Calhoun Liberal, Kansas

STATE OF Kansas, COUNTY OF Franklin, ss.
Lawrence O. Tank, Jr (employee of owner) or (owner/proprietor) of the above-described well, being first duly sworn on oath, says: That I have knowledge of the facts, statements, and matters herein contained and the log of the above-described well as filed and that the same are true and correct. So help me God.

(Signature) [Signature]
Box 717 Mc Pherson, Kansas
(Address)

Subscribed and sworn to before me this 9th day of January, 1961

[Signature]
Notary Public.

