

STATE OF KANSAS
STATE CORPORATION COMMISSION

Form CP-4

WELL PLUGGING RECORD

Give All Information Completely
Make Required Affidavit
Mail or Deliver Report to:
Conservation Division
State Corporation Commission
212 No. Market
Wichita, Kansas

Haskell County, Sec. 4 Twp. 28 Rge. 33 (SE) (W)

Location as "NE/CNW/SW" or footage from lines Center SE/4

Lease Owner Ashland Oil & Refining Company

Lease Name F. Roy Well No. 5-A

Office Address P.O. Box 127 - Satanta, Kansas 67870

Character of Well (completed as Oil, Gas or Dry Hole) Dry Hole

Date well completed October 1 19 69

Application for plugging filed January 22 19 69

Application for plugging approved January 23 19 69


Plugging commenced January 30 19 69

Plugging completed January 31 19 69

Reason for abandonment of well or producing formation
Dry - No gas

If a producing well is abandoned, date of last production No production 19

Was permission obtained from the Conservation Division or its agents before plugging was commenced? Yes

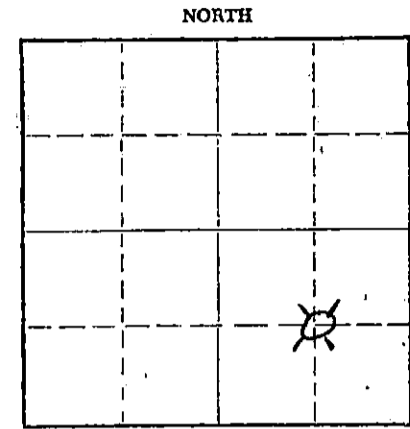

Locate well correctly on above Section Plat

Name of Conservation Agent who supervised plugging of this well Edgar J. Eves

Producing formation Chase Group Depth to top Bottom Total Depth of Well 2859 Feet

Show depth and thickness of all water, oil and gas formations.


OIL, GAS OR WATER RECORDS

CASING RECORD

FORMATION	CONTENT	FROM	TO	SIZE	PUT IN	PULLED OUT
Chase Group	-0-			8 5/8"	770'	-0-
				5 1/2"	2859'	1503'

Describe in detail the manner in which the well was plugged, indicating where the mud fluid was placed and the method or methods used in introducing it into the hole. If cement or other plugs were used, state the character of same and depth placed, from feet to feet for each plug set.

8 5/8" to 770' Circulated with cement
 5 1/2" to 2859' Cemented
 Top perforation 2663' Plugged bottom w/20 sacks cement
 Top of cement 2350'
 Mud 2350' to 700'
 Spotted 40 sacks cement 700' to 600'
 Mud 600' to 45'
 Plug, hulls and 15 sacks cement 45' to 0'
 Company pump
 Pulled 1503' of 5 1/2" Casing

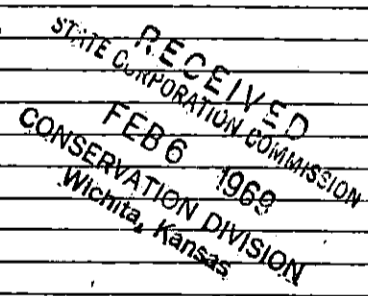

(If additional description is necessary, use BACK of this sheet)
Name of Plugging Contractor Sargents Casing Pulling Company
Address P.O. Box 506 - Liberal, Kansas License No. 511

STATE OF Kansas, COUNTY OF Haskell, ss. Felix C. Turley (employee of owner) or (owner or operator) of the above-described well, being first duly sworn on oath, says: That I have knowledge of the facts, statements, and matters herein contained and the log of the above-described well as filed and that the same are true and correct. So help me God.

(Signature) Felix C. Turley
P.O. Box 127 - Satanta, Kansas 67870
(Address)

SUBSCRIBED AND SWORN TO before me this 5th day of February, 19 69

My commission expires October 1, 1969

H. T. Ungles Notary Public.