

5-081-00206-0000

STATE OF KANSAS
STATE CORPORATION COMMISSION

Form CP-4

WELL PLUGGING RECORD

Give All Information Completely
Make Required Affidavit
Mail or Deliver Report to:
Conservation Division
State Corporation Commission
212 No. Market
Wichita, Kansas

Haskell County, Sec. 4 Twp. 28 Rge. 33 (W)

Location as "NE/CNW/SW" or footage from lines Approximate Center
Lease Owner Ashland Oil & Refining Company

Lease Name F. Roy Well No. 5

Office Address P.O. Box 127 - Satanta, Kansas 67870

Character of Well (completed as Oil, Gas or Dry Hole) Gas

Date well completed 7 - 13 19 52

Application for plugging filed 1 - 22 19 69

Application for plugging approved 1 - 23 19 69

Plugging commenced 1 - 28 19 69


Plugging completed 1 - 29 19 69

Reason for abandonment of well or producing formation _____

Small amount of gas with H2S and water

If a producing well is abandoned, date of last production February 19 65

Was permission obtained from the Conservation Division or its agents before plugging was commenced? Yes

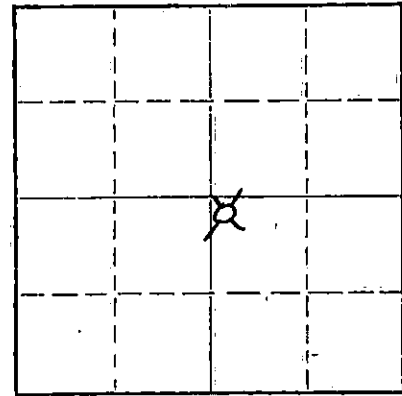

Locate well correctly on above Section Plat

Name of Conservation Agent who supervised plugging of this well Edgar J. Eves

Producing formation Chase Group Depth to top 2647 Bottom 2767 Total Depth of Well 2767 Feet

Show depth and thickness of all water, oil and gas formations.

OIL, GAS OR WATER RECORDS

CASING RECORD

FORMATION	CONTENT	FROM	TO	SIZE	PUT IN	PULLED OUT
Chase Group	Gas	2647	2767	10 3/4"	675'	-0-
				7"	2729'	650'

Describe in detail the manner in which the well was plugged, indicating where the mud fluid was placed and the method or methods used in introducing it into the hole. If cement or other plugs were used, state the character of same and depth placed, from _____ feet to _____ feet for each plug set.

10 3/4" to 675' Circulated w/cement
 7" to 2729' Cemented
 Top perforation 2647'
 Well sanded up to 2000'
 Mud 2000' to 800'
 Spotted 25 sacks cement 800' to 675'
 Mud 675' to 630'
 Spotted 45 sacks cement 630' to 470'
 Mud 470' to 40'
 Plug, hulls and 15 sacks cement 40' to 0'
 Pulled 650' of 7' Casing
 Company pump.

RECEIVED
STATE CORPORATION COMMISSION
FEB 5 1969
CONSERVATION DIVISION
Wichita, Kansas

(If additional description is necessary, use BACK of this sheet)

Name of Plugging Contractor Sargents Casing Pulling Company

Address P.O. Box 506 - Liberal, Kansas License No. 511

STATE OF Kansas COUNTY OF Haskell, ss.
Felix C. Turley (employee of owner) or (owner or operator) of the above-described well, being first duly sworn on oath, says: That I have knowledge of the facts, statements, and matters herein contained and the log of the above-described well as filed and that the same are true and correct. So help me God.

(Signature) Felix C. Turley

P.O. Box 127 - Satanta, Kansas 67870
(Address)

SUBSCRIBED AND SWORN TO before me this 5th day of February, 19 69

My commission expires October 1, 1970

H. T. Ungles
Notary Public.

MAILED PRODUCING CO

RECEIVED

15-081-00208-0000

LOG OF WELL
UNITED PRODUCING COMPANY
F. ROY #5

<u>FROM</u>	<u>TO</u>	<u>FORMATION</u>
0'	20	Surface clay
20	450	Sand and clay
450	682	Sand, gravel, red bed, blue shale
682	770	Blue shale
770	930	Blue shale, gypsum
930	1170	Red bed
1170	1360	Red bed
1360	1410	Shale, anhydrite
1410	1430	Red bed, shale
1430	1470	Lime, anhydrite, red bed, shale
1470	1700	Red bed
1700	1770	Red bed, lime, shale
1770	1830	Red bed, lime
1830	1947	Red bed
1947	2006	Lime
2006	2035	Shale, anhydrite
2035	2045	Shale
2045	2080	Red bed, shale, lime
2080	2115	Red bed, shale
2115	2152	Red bed, lime
2152	2211	Lime
2211	2240	Flint rock
2240	2300	Lime, shale
2300	2388	Anhydrite, lime, shale
2388	2415	Red bed, shale, lime
2415	2425	Lime, shale
2425	2485	Lime, shale, anhydrite
2485	2575	Lime, shale breaks
2575	2630	Lime, anhydrite, broken shale
2630	2670	Lime, shale
2670	2750	Anhydrite, shale, lime
2750	2772	Lime
Ground Level	2767	

Set and cemented 10-3/4" O. D. casing at 673 Ft. 350 sacks cement

Set and cemented 7" O. D. casing at 2729 Ft. 500 sacks cement

Began drilling: June 9, 1952. Completed June 17, 1952

Drillers: W. E. Reed, J. D. Archer and M. Roberts

Contractor: Stovall Drilling Company, Inc.

RECEIVED
STATE CORPORATION COMMISSION

JAN 23 1969

CONSERVATION DIVISION
Wichita, Kansas