


WELL PLUGGING RECORD

Give All Information Completely
Make Required Affidavit
Mail or Deliver Report to:
Conservation Division
State Corporation Commission
211 No. Broadway
Wichita, Kansas

Haskell County, Sec. 5 Twp. 28S Rge. 33W(E) (W)

Location as "NE/CNWxSWx" or footage from lines C SW 1/4
Lease Owner Southwestern Exploration Company
Lease Name Batman Well No. 1
Office Address 204 Derby Bldg. - Wichita, Kansas
Character of Well (completed as Oil, Gas or Dry Hole) Dry Hole
Date well completed June 10 19 55
Application for plugging filed January 24 19 56
Application for plugging approved January 24 19 56
Plugging commenced January 25 19 56
Plugging completed January 26 19 56
Reason for abandonment of well or producing formation Dry Hole

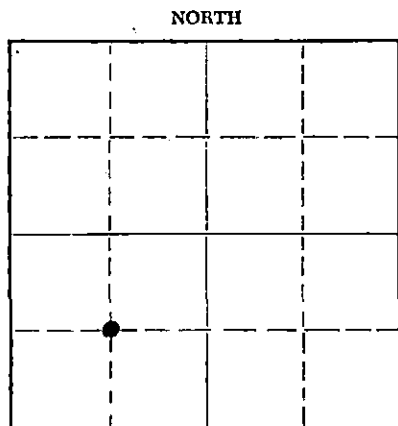

Locate well correctly on above Section Plat

If a producing well is abandoned, date of last production _____ 19 ____
Was permission obtained from the Conservation Division or its agents before plugging was commenced? Yes

Name of Conservation Agent who supervised plugging of this well Merle Rives
Producing formation _____ Depth to top _____ Bottom _____ Total Depth of Well 2851 Feet
Show depth and thickness of all water, oil and gas formations.

OIL, GAS OR WATER RECORDS

CASING RECORD

FORMATION	CONTENT	FROM	TO	SIZE	PUT IN	PULLED OUT
				8-5/8"	472'	None
				5-1/2"	2850'	817'
				Hole was plugged back to		
				2741' and casing perforated		
				at 2694'.		

Describe in detail the manner in which the well was plugged, indicating where the mud fluid was placed and the method or methods used in introducing it into the hole. If cement or other plugs were used, state the character of same and depth placed, from _____ feet to _____ feet for each plug set.

Filled the hole with sand from 2741' to 2685' and ran 5 sacks of cement. Mudded the hole to 1100' then pulled 817' of 5 1/2" casing. Mudded the hole to 470', set a 10' rock bridge and ran 20 sacks of cement. Mudded the hole to 35', set a 10' rock bridge and ran 10 sacks of cement on top. Plugging completed.

RECEIVED
STATE CORPORATION COMMISSION
FEB 8 1956
CONSERVATION DIVISION
Wichita, Kansas

2-8-1966

(If additional description is necessary, use BACK of this sheet)
Name of Plugging Contractor West Supply Co., Inc.
Address Chase, Kansas

STATE OF KANSAS, COUNTY OF SEDGWICK, ss.
M. S. Davis (employee of owner) ~~State Corporation Commission~~ of the above-described

well, being first duly sworn on oath, says: That I have knowledge of the facts, statements, and matters herein contained and the log of the above-described well as filed and that the same are true and correct. So help me God.

(Signature) M. S. Davis
204 Derby Bldg., Wichita, Kansas
(Address)

SUBSCRIBED AND SWORN TO before me this 7th day of February, 19 56

My commission expires 10/28/1959

Joanne Helmer Spence
Notary Public.

PLUGGING
FILE SEC 5 T 28 R 33W
BOOK PAGE 30 LINE 31



DRILLING COMPANY, INC. FORM 3 1279 352 N. BROADWAY WICHITA, KANSAS

Southwestern Exploration Company
 #1 Batman
 C SW/4 Section 5-28-33W
 Haskell County, Kansas

15-081-00709-0000

Southwestern Exploration Company
 503 Union National Bank Building
 Wichita 2, Kansas

Elevation: 3014 R.B.
 Spudded: May 1, 1955
 Rotary Completed: May 6, 1955
 Contractor: Rocket Drilling Company, Inc.

CASING RECORD

472' 8-5/8" O.D. 24# seamless casing cemented with 300 sacks cement.
 2848' 5-1/2" O.D. 14# seamless casing cemented with 450 sacks cement.

DRILLERS LOG

Sand & Clay	0 to 200	Sand Streaks, Shale &	
Sand	410	Shells	1910
Shale	475	Broken Lime	2588
Red Bed	1090	Lime	2765
Shale, Red Bed & Sand	1690	Broken Lime	2830
		Lime	2850 TD

STATE OF KANSAS)
) SS:
 COUNTY OF SEDGWICK)

I hereby certify that to the best of my knowledge and belief, the foregoing log is true and correct.

ROCKET DRILLING COMPANY, INC.

L. H. Myrick

L. H. Myrick

Subscribed and sworn to before me, a Notary Public, in and for the County and State aforesaid, this 10th day of May, 1955.

Patricia Mae Burns
 Notary Public

My Commission Expires: March 5, 1958

PLUGGING
 FBI SEC 5 T 28 R 33W
 BOOK PAGE 30 LINE 31

RECEIVED
 STATE OF KANSAS
 JAN 12 1956
 CONSERVATION DIVISION
 Wichita, Kansas