

WELL PLUGGING RECORD

Give All Information Completely  
Make Required Affidavit  
Mail or Deliver Report to:  
Conservation Division  
State Corporation Commission  
211 No. Broadway  
Wichita, Kansas

HASKELL County. Sec. 7 Twp. 28 Rge. 34 (W)

Location as "NE/CNW/SW" or footage from lines C SE SE

Lease Owner PETROLEUM, INC.

Lease Name EUBANK Well No. 1

Office Address ROUTE 2, GREAT BEND, KANSAS

Character of Well (completed as Oil, Gas or Dry Hole) DRY HOLE

Date well completed JANUARY 30 19 59

Application for plugging filed JANUARY 30 19 59

Application for plugging approved JANUARY 30 19 59


Plugging commenced JANUARY 30 19 59

Plugging completed JANUARY 30 19 59

Reason for abandonment of well or producing formation NO PRODUCIBLE ZONES

If a producing well is abandoned, date of last production NONE 19

Was permission obtained from the Conservation Division or its agents before plugging was commenced? YES

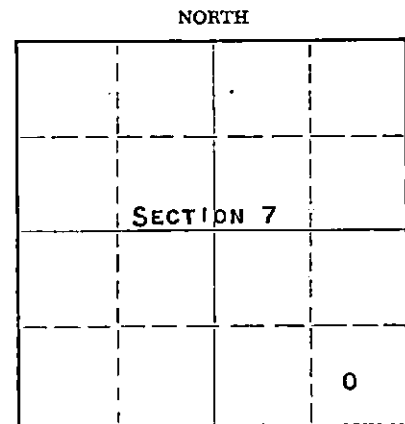

Locate well correctly on above Section Plat

Name of Conservation Agent who supervised plugging of this well MERLE RIVES

Producing formation ----- Depth to top ----- Bottom ----- Total Depth of Well 5760 Feet

Show depth and thickness of all water, oil and gas formations.

OIL, GAS OR WATER RECORDS

CASING RECORD

| FORMATION | CONTENT | FROM | TO | SIZE   | PUT IN | PULLED OUT |
|-----------|---------|------|----|--------|--------|------------|
|           |         |      |    | 8-5/8" | 1907'  | NONE       |
|           |         |      |    |        |        |            |
|           |         |      |    |        |        |            |
Describe in detail the manner in which the well was plugged, indicating where the mud fluid was placed and the method or methods used in introducing it into the hole. If cement or other plugs were used, state the character of same and depth placed, from \_\_\_\_\_ feet to \_\_\_\_\_ feet for each plug set.

MUD UP FROM 5760' TO 2900' WITH HEAVY MUD. PLACED 180 SACKS FROM 2900' TO 2600'.  
MUD UP TO 600' FOLLOWED BY A WOODEN PLUG. PLACED 20 SACKS CEMENT THROUGH DRILL PIPE ON TOP OF PLUG. MUD UP TO 35' FOLLOWED BY A WOODEN PLUG. FILLED HOLE TO BASE OF WELL CELLAR WITH 5 SACKS CEMENT.

RECEIVED  
STATE CORPORATION COMMISSION  
FEB 11 1959  
CONSERVATION DIVISION  
Wichita, Kansas

Name of Plugging Contractor GARVEY DRILLING COMPANY  
Address ROUTE 2, GREAT BEND, KANSAS

STATE OF KANSAS, COUNTY OF BARTON, ss.  
R. G. COSHOW (employee of owner) or (owner) of the above-described well, being first duly sworn on oath, says: That I have knowledge of the facts, statements, and matters herein contained and the log of the above-described well as filed and that the same are true and correct. So help me God. DIVISIONAL PROD. SUPT.

(Signature) *R. G. Coshow*  
ROUTE 2, GREAT BEND, KANSAS  
(Address)

SUBSCRIBED AND SWORN TO before me this 10TH day of FEBRUARY, 19 59

*Ed. J. Brown*  
Notary Public.

My commission expires JULY 11, 1960

PLUGGING  
FILE SEC 7 T 28 R34 W  
BOOK PAGE 14 LINE 5

# WELL LOG

15-081-10050-0000

COMPANY PETROLEUM, INCORPORATED

SEC. 7 T. 28S R. 34W

FARM EUBANK

NO. 1

LOC. C-SE, SE


TOTAL DEPTH 5760'

COUNTY HASKELL CO., KANSAS

COMM. December 31, 1958

COMP. January 30, 1959

CONTRACTOR GARVEY DRILLING COMPANY

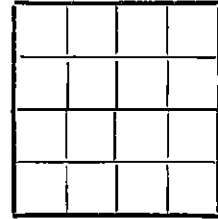

CASING 8 5/8" @ 1907' W/950 sax.

ELEVATION 3070' DF

PRODUCTION D & A

FIGURES INDICATE BOTTOM OF FORMATIONS

|        |                      |
|--------|----------------------|
| 180    | Gyp & sand           |
| 865    | Shale & sand         |
| 1720   | Red bed              |
| 1907   | Gyp & red bed        |
| 2575   | Shale & shells       |
| 2750   | Shale & sand         |
| 2870 = | Shale                |
| 3020   | Shale & chalk        |
| 3064   | Shale & lime         |
| 3776   | Shale & chalk        |
| 3870   | Chalk & sticky shale |
| 4300   | Lime                 |
| 4394   | Lime & shale         |
| 4924   | Lime                 |
| 5090   | Lime & shale         |
| 5123   | Lime                 |
| 5215   | Lime & shale         |
| 5270   | Lime & chert         |
| 5376   | Shale & chert        |
| 5415   | Shale & lime         |
| 5430   | Shale & sand         |
| 5445   | Sand, shale & lime   |
| 5610   | Shale & lime         |
| 5660   | Lime & shale         |
| 5710   | Shale & lime         |
| 5760   | Lime & shale         |
| 5760   | T. D.                |

**RECEIVED**  
 STATE CORPORATION COMMISSION  
 FEB 11 1959  
 CONSERVATION DIVISION  
 Wichita, Kansas

**PLUGGING**  
 FILE SEC. 7 T. 28 R. 34W  
 BOOK PAGE 14 LINE 5

State of KANSAS }  
 County of BARTON } ss:

I, VERNE A. MORRIS of GARVEY DRILLING COMPANY

upon oath state that the above and foregoing is a true and correct copy of the log of the #1 EUBANK well

Subscribed and sworn to before me this 6th day of February 1959

My Commission Expires: July 11, 1960

*Verne A. Morris*  
 \_\_\_\_\_  
*John F. Bissner*  
 \_\_\_\_\_  
 NOTARY PUBLIC