

STATE OF KANSAS
STATE CORPORATION COMMISSION

Give All Information Completely
Make Required Affidavit
Mail or Deliver Report to:
Conservation Division
State Corporation Commission
211 No. Broadway
Wichita, Kansas

15-081-10074-0001

WELL PLUGGING RECORD

Haskell County, Sec. 28 Twp. 28S Rge. 34 (S) (W)

Location as "NE/CNW/SW" or footage from lines G of NW NE

Lease Owner Helmerich & Payne, Inc.

Lease Name Eubank Well No. G-1 (No. 5)

Office Address Box 558, Garden City, Kansas

Character of Well (completed as Oil, Gas or Dry Hole) Dry Hole

Date well completed Completion Attempts to: 1-23- 19 60

Application for plugging filed 8-11- 19 62

Application for plugging approved 8-13- 19 62


Plugging commenced 8-12- 19 62

Plugging completed 8-14- 19 62

Reason for abandonment of well or producing formation Non-commercial

If a producing well is abandoned, date of last production - 19

Was permission obtained from the Conservation Division or its agents before plugging was commenced? Yes

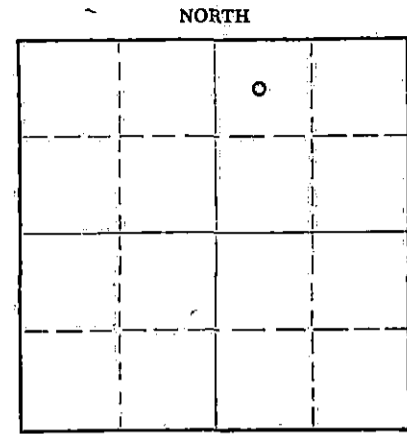

Locate well correctly on above Section Plat

Name of Conservation Agent who supervised plugging of this well Hugh Scott

Producing formation - Depth to top - Bottom - Total Depth of Well 5474 (4617' PB) Feet

Show depth and thickness of all water, oil and gas formations.

OIL, GAS OR WATER RECORDS

CASING RECORD

FORMATION	CONTENT	FROM	TO	SIZE	PUT IN	PULLED OUT
				8-5/8"	790.00	0
				5 1/2"	5530.00	1193.00

Describe in detail the manner in which the well was plugged, indicating where the mud fluid was placed and the method or methods used in introducing it into the hole. If cement or other plugs were used, state the character of same and depth placed, from feet to feet for each plug set.

Plugged back with sand from 4617' to 4580'. Mixed and dumped 5 sacks of cement from 4580' to 4540'. Pulled casing. Mudded hole to 710'. Set 10' rock bridge from 710' to 700'. Mixed and dumped 35 sacks cement from 700' to 595'. Mudded hole from 595' to 55'. Set 5' rock bridge from 55' to 50'. Mixed and dumped 15 sacks cement from 50' to base of the cellar.

RECEIVED
STATE CORPORATION COMMISSION

AUG 20 1962

CONSERVATION DIVISION
Wichita, Kansas

8-20-1962

(If additional description is necessary, use BACK of this sheet)

Name of Plugging Contractor Ace Pipe Pulling Company

Address P. O. Box 304, Great Bend, Kansas

STATE OF Kansas, COUNTY OF Finney, ss.

T. E. Mort

(employee of owner) or (owner/representative) of the above-described

well, being first duly sworn on oath, says: That I have knowledge of the facts, statements, and matters herein contained and the log of the above-described well as filed and that the same are true and correct. So help me God.

(Signature) T. E. Mort

P. O. Box 558, Garden City, Kansas (Address)

SUBSCRIBED AND SWORN to before me this 17th day of August, 19 62

Robert M. Boyd

Notary Public.

My commission expires July 1, 1964



EUBANK C-1
White Eagle Oil Company
C NW NE Section 28-28S-34W
Haskell County, Kansas

CASING RECORD:

8-5/8" @ 800' w/400 sxs. Pozmix & 100 sxs. Regular; 2%CC
 5-1/2" @ 5550' w/250' sxs. Pozmix; 12%Gel

COMMENCED: 7-9-59
 COMPLETED: 7-27-59

	<u>FROM</u>	<u>TO</u>
Sand & Surface Clay	0	74
Sand	74	800
Red Bed & Shells	800	1860
Shale & Shells	1860	2375
Shale & Lime	2375	2610
Shale & Shells	2610	2690
Shale & Lime	2690	2810
Shale & Anhydrite	2810	2925
Anhydrite & Shale	2925	3002
Lime & Shale	3002	3102
Shale & Lime	3102	3229
Lime & Shale	3229	3422
Shale & Lime	3422	3496
Lime & Shale	3496	3724
Shale & Lime	3724	3857
Lime & Shale	3857	4674
Lime, Shale & Sand	4674	4718
Lime & Shale	4718	5068
Lime	5068	5143
Lime & Shale	5143	5228
Sandy lime & Shale	5228	5368
Lime & Shale	5368	5550
TOTAL DEPTH		5550

RECEIVED
 STATE CORPORATION COMMISSION
 AUG 13 1962
 CONSERVATION DIVISION
 Wichita, Kansas

STATE OF OKLAHOMA)
)
 County of Tulsa)

I hereby affirm that the above and foregoing is a true and correct copy of the log of the Eubank C-1 well, located in Section 28-28S-34W, Haskell County, Kansas.

HELMERICH & PAYNE, INC.
Darryl Saye
 Vice President

Subscribed and sworn to before me a Notary Public this 5th day of August, 1959.

Margaret Bailey
 Notary Public

My commission expires:
 March 30, 1960.