

WELL PLUGGING RECORD 15-081-10064-0000

Give All Information Completely
Make Required Affidavit
Mail or Deliver Report to:
Conservation Division,
State Corporation Commission
211 No. Broadway
Wichita, Kansas

Haskell

County. Sec. 28 Twp. 28s Rge. 34 W(E) (W)

Location as "NE/CNW/SW" or footage from lines 50 ft. N C W/4 ne 1/4

Lease Owner Graham-Michaelis Drilling Co.

Lease Name Eubank

Well No. 3-28

Office Address: Box 1294 Liberal, Kansas

Character of Well (completed as Oil, Gas or Dry Hole) Dry

Date well completed 4-25 19 61

Application for plugging filed 12-3 19 66

Application for plugging approved 12-5 19 66


Plugging commenced 12-5 19 66

Plugging completed 12-7 19 66

Reason for abandonment of well or producing formation Dry

If a producing well is abandoned, date of last production 19

Was permission obtained from the Conservation Division or its agents before plugging was commenced? Yes

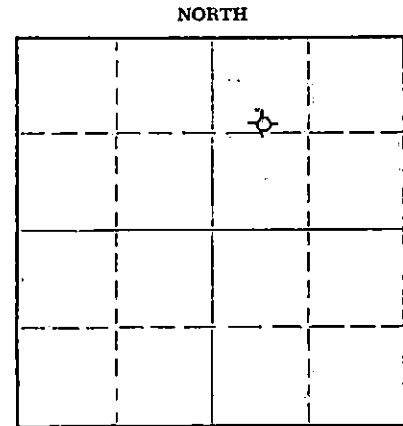

Locate well correctly on above Section Plat

Name of Conservation Agent who supervised plugging of this well Ed Eves

Producing formation Perforations @ 5472 Depth to top _____ Bottom _____ Total Depth of Well 5605 Ft. feet

Show depth and thickness of all water, oil and gas formations.

OIL, GAS OR WATER RECORDS

CASING RECORD

FORMATION	CONTENT	FROM	TO	SIZE	PUT IN	PULLED OUT
				8 5/8	782	0
				4 1/2	5604	1926

Describe in detail the manner in which the well was plugged, indicating where the mud fluid was placed and the method or methods used in introducing it into the hole. If cement or other plugs were used, state the character of same and depth placed, from _____ feet to _____ feet for each plug set.

Mix 20 sacks cement to plug off perforations at 5472'. Stop plug at 5300 feet. Shoot pipe loose at 1926 and lay down same to 700 ft. Mix mud and pump 40 sacks cement at 700 to 600 feet. Lay down all casing and put 10 sacks cement at 35 feet to 0 feet. Cut off and cap 8 5/8.

RECEIVED
STATE CORPORATION COMMISSION

DEC 21 1966

CONSERVATION DIVISION
Wichita, Kansas

12-21-1966

(If additional description is necessary, use BACK of this sheet)

Name of Plugging Contractor Sargents Casing Pulling Service

Address Box 506 Liberal, Kansas

STATE OF Kansas, COUNTY OF Sedgwick, ss.

David Patterson (employee of owner) or (conservator/agent) of the above-described well, being first duly sworn on oath, says: That I have knowledge of the facts, statements, and matters herein contained and the log of the above-described well as filed and that the same are true and correct. So help me God.

(Signature)

David F. Patterson

Graham-Michaelis Drilling, Inc.
211 North Broadway, (Address) Wichita, Kansas 67202

SUBSCRIBED AND SWORN to before me this 20th day of December 1966

Evelyn D. Evans

Notary Public.

My commission expires Dec. 12, 1970

EUBANK #3-28

WELL RECORD:

LOCATION:

Section 28-28S-34W
Haskell County, Kansas

Commenced: 4/5/61
Completed: 4/25/61
(Rotary)

CONTRACTOR:

Graham-Michaelis Drilling Co.
Liberal Division
P. O. Box 896
Liberal, Kansas

15-081-10064-0000

CASING RECORD:

25 Joints 8 5/8" 21# Casing
Cemented w/150 sx L.W. 2% cc
and 150 sx Common 2% cc

	<u>LOG</u>	
Sand & Clay	0	110
Surface Clay	110	175
Sand	175	430
Shale	430	783
Red Bed	783	1180
Shale & Shells	1180	1813
Red Bed & Shale	1813	2130
Shale & Shells	2130	2285
Shale & Lime	2285	3199
Lime	3199	3316
Shale, Lime & Chalk	3316	3435
Lime & Shale	3435	3560
Lime	3560	3710
Lime & Shale	3710	4005
Lime	4005	4123
Lime & Shale	4123	4323
Lime	4323	4415
Lime & Shale	4415	4594
Lime	4594	4667
Lime & Shale	4667	4750
Lime	4750	5083
Lime & Shale	5083	5155
Lime	5155	5307
Lime & Shale	5307	5500
Lime	5500	5582
Lime & Shale	5582	5605

RECEIVED
STATE CORPORATION COMMISSION
DEC 21 1966
CONSERVATION DIVISION
Wichita, Kansas

5605' - Total Rotary Depth

The undersigned, Graham-Michaelis Drilling Company, Liberal Division, certifies that the above log is a true and correct copy of the formations encountered in drilling the above mentioned well, as taken from the Daily Drilling Report.

GRAHAM-MICHAELIS DRILLING COMPANY
LIBERAL DIVISION

By H. R. Michaelis
H. R. Michaelis