


WELL PLUGGING RECORD

Give All Information Completely
Make Required Affidavit
Mail or Deliver Report to:
Conservation Division
State Corporation Commission
211 No. Broadway
Wichita, Kansas

Sedgwick County, Sec. 13 Twp. 26S Rge. 1 (E) (W)

Location as "NE/CNW/SW" or footage from lines SW SW NW
Lease Owner Raymond Oil Company, Inc.
Lease Name Stabler Well No. 1
Office Address 410 4th National Bank Bldg., Wichita 2, Kansas
Character of Well (completed as Oil, Gas or Dry Hole) Dry Hole
Date well completed December 8 19 58
Application for plugging filed December 8 19 59
Application for plugging approved December 11 19 59
Plugging commenced December 8 19 59
Plugging completed December 8 19 59
Reason for abandonment of well or producing formation _____

NORTH

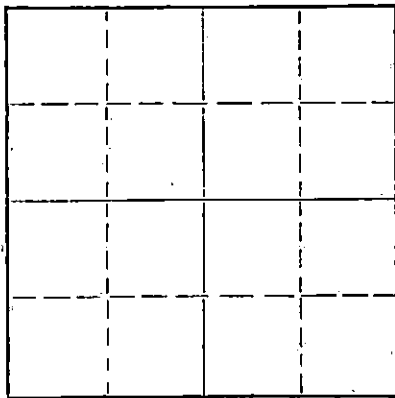

Locate well correctly on above
Section Plat

If a producing well is abandoned, date of last production _____ 19____
Was permission obtained from the Conservation Division or its agents before plugging was commenced? Yes

Name of Conservation Agent who supervised plugging of this well Lee Guthrie
Producing formation _____ Depth to top _____ Bottom _____ Total Depth of Well 3499 Feet
Show depth and thickness of all water, oil and gas formations:

OIL, GAS OR WATER RECORDS

CASING RECORD

FORMATION	CONTENT	FROM	TO	SIZE	PUT IN	PULLED OUT

Describe in detail the manner in which the well was plugged, indicating where the mud fluid was placed and the method or methods used in introducing it into the hole. If cement or other plugs were used, state the character of same and depth placed, from _____ feet to _____ feet for each plug set.

Layed down drill pipe, set bridge plug at 220' with 4 sacks hulls on top and 18 sacks cement. Filled hole to 45', set bridge plug and 1/4 sack hulls and 10 sacks cement on top. Cemented rat hole with 2 sacks cement.

RECEIVED
STATE CORPORATION COMMISSION

JAN 18 1960

CONSERVATION DIVISION
Wichita, Kansas

1-18-1960

(If additional description is necessary, use BACK of this sheet)

Name of Plugging Contractor Raymond Oil Company, inc.
Address 410 Fourth National Bank Bldg., Wichita 2, Kansas

STATE OF KANSAS COUNTY OF SEDGWICK, ss.
Wm. Mike Raymond (owner or operator) of the above-described well, being first duly sworn on oath, says: That I have knowledge of the facts, statements, and matters herein contained and the log of the above-described well as filed and that the same are true and correct. So help me God.

(Signature) Wm. Mike Raymond
410 4th National Bank Bldg., Wichita, Ks. (Address)

SUBSCRIBED AND SWORN TO before me this 15 day of December, 19 59

My commission expires May 13, 1962
Mary Ellen Sampson Notary Public.



R

Raymond Oil Company, Inc. #1 Stabler
 SW SW NW, 13-26S-1W
 Sedgwick County, Kansas

Elevation: 1344 KB
 1337 DF
 1335 GL

Contractor: Company Tools - Rig #2
 Commenced: November 25, 1959
 Completed: December 8, 1959

Casing Record:
 8-5/8" @ 211' w/200 sacks 2% CC

figures Indicate Bottom of Formation

<u>Formation</u>	<u>Depth</u>
Surface Soil - sand	45
Shale	185
Lime & Shale - surface hole	211
Anhydrite Lime	225
Shale & Shells, & Lime	260
Lime, shale & shells	560
Lime & Shale	1010
Shale	1320
Shale & Lime	2400
Lime	2450
Shale	2531
Lime	2542
Shale	2580
Lime	2746
Shale	2810
Lime	2860
Shale	2880
Lime	3000
Shale, sand	3058
Chert	3082
Dolomite	3105
Lime, cherty	3296
Shale	3389
Dolomite	3416
Sand	3499
D & A	

RECEIVED
 STATE CORPORATION COMMISSION
 JAN 18 1960
 CONSERVATION DIVISION
 Wichita, Kansas


Tops:

Lansing	2400'
Kansas City	2580'
Base Kansas City	2746'
Marmaton	2810'
Mississippian	3058'
Mississippi Lime	3105'
Kinderhook	3296'
Viola	3389'
Simpson	3416'
RTD	3499'

STATE OF KANSAS)
) SS
 COUNTY OF SEDGWICK)

I hereby certify that the above is true and correct to the best of my knowledge.

Rick P. Clinton
 Rick P. Clinton

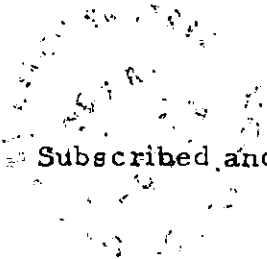

Subscribed and sworn to before me this 9th day of December, 1959.

My Commission Expires: 5/13/62

Walter E. Simpson
 Notary Public