

STATE CORPORATION COMMISSION OF KANSAS
OIL & GAS CONSERVATION DIVISION
WELL COMPLETION OR RECOMPLETION FORM
ACO-1 WELL HISTORY
DESCRIPTION OF WELL AND LEASE

Plugged 5-27-89
SIDE ONE

API NO. 15-097-21, 273-0000

County KIOWA

APPROX 1/2 NW NW Sec 15 Twp 27 Rge 20 East
X West

4260 Ft North from Southeast Corner of Section
4560 Ft West from Southeast Corner of Section
(Note: Locate well in section plat below)


Lease Name BRENSING Well # 16-2

Field Name FRALICK WEST

Producing Formation MISSISSIPPIAN

Elevation: Ground 2241' KB 2294'

Section Plat

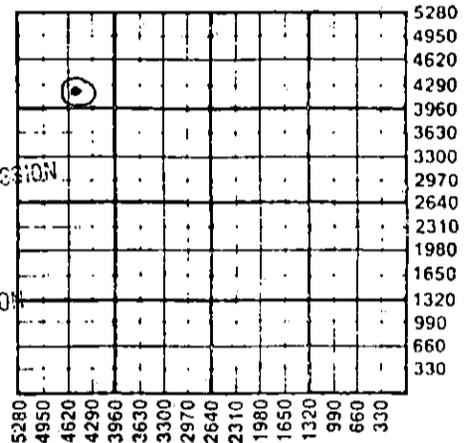

RECEIVED
STATE CORPORATION COMMISSION
JUN 6 1989
CONSERVATION DIVISION
Wichita, Kansas

Operator: License # 4243
Name CROSS BAR PETROLEUM, INC.
Address P.O. BOX 20040
City/State/Zip WICHITA, KS. 67208

Purchaser NONE

Operator Contact Person ALBERT BRENSING
Phone 316/799-2933

Contractor: License # 5380
Name EAGLE DRILLING, INC.

Wellsite Geologist ALBERT BRENSING
Phone 316/799-2933

Designate Type of Completion
 New Well Re-Entry Workover
 Oil SWD Temp Abd
 Gas Inj Delayed Comp.
 Dry Other (Core, Water Supply etc.)

If OWHO: old well info as follows:
Operator
Well Name
Comp. Date Old Total Depth

WELL HISTORY

Drilling Method:
 Mud Rotary Air Rotary Cable

5-20-89 5-28-89 5-28-89
Spud Date Date Reached TD Completion Date

5475' 5450'
Total Depth PBDT

Amount of Surface Pipe Set and Cemented at 441 feet
Multiple Stage Cementing Collar Used? Yes No
If yes, show depth set...feet
If alternate 2 completion, cement circulated from...feet depth to...w/...SX cmt
Cement Company Name HALLIBURTON
Invoice # 781296

Air I D&O

WATER SUPPLY INFORMATION
Disposition of Produced Water: Disposal
Docket # Repressuring

Questions on this portion of the ACO-1 call:

Water Resources Board (913) 296-3717

Source of Water:
Division of Water Resources Permit # 890130
APPROX

Groundwater 3660 Ft North from Southeast Corner
(Well) 4000 Ft West from Southeast Corner of
Sec 15 Twp 27 Rge 20 East West

Surface Water...Ft North from Southeast Corner
(Stream, pond etc)...Ft West from Southeast Corner
Sec Twp Rge East West

Other (explain) (purchased from city, R.W.D. #)

INSTRUCTIONS: This form shall be completed in triplicate and filed with the Kansas Corporation Commission, 200 Colorado Derby Building, Wichita, Kansas 67202, within 120 days of the spud date of any well. Rule 82-3-130, 82-3-107 and 82-3-106 apply. Information on side two of this form will be held confidential for a period of 12 months if requested in writing and submitted with the form. See rule 82-3-107 for confidentiality in excess of 12 months. One copy of all wireline logs and drillers time log shall be attached with this form. Submit QP-4 form with all plugged wells. Submit CP-111 form with all temporarily abandoned wells.

All requirements of the statutes, rules and regulations promulgated to regulate the oil and gas industry have been fully complied with and the statements herein are complete and correct to the best of my knowledge.

Signature *Albert B*
Title PRESIDENT Date 6-5-89

Subscribed and sworn to before me this 5TH day of JUNE 1989
Notary Public *Joan Whitehead*
Date Commission Expires 4-27-93

K.C.C. OFFICE USE ONLY

Letter of Confidentiality Attached
 Wireline Log Received
 Drillers Time Log Received

Distribution
 KCC SWD/Rep NGPA
 KGS Plug Other (Specify)

6-6-89
Form ACO-1 (5-86)

Sec 15, Twp 27, Rge 20

