

This form shall be filed in duplicate with the Kansas Corporation Commission, 200 Colorado Derby Building, Wichita, Kansas 67202, within ten days after the completion of the well, regardless of how the well was completed.

Attach separate letter of request if the information is to be held confidential. If confidential, only file one copy. Information on side one will be of public record and side two will then be held confidential.

Circle one: Oil, Gas, Dry, SWD, OWWO, Injection. Type and complete ALL sections. Applications must be filed for dual completion, commingling, SWD and injection.

Attach wireline logs (i.e. electrical log, sonic log, gamma ray neutron log, etc.). KCC # (316) 263-3238. (Rules 82-2-105 & 82-2-125)

OPERATOR Deck Oil Company

API NO. 15-097-20,847-0000

ADDRESS Suite 4000 - One Williams Center
Tulsa, OK 74172

COUNTY Kiowa

FIELD

**CONTACT PERSON
PHONE

PROD. FORMATION

PURCHASER

LEASE Pearson

ADDRESS

WELL NO. #1

WELL LOCATION C SW NE

DRILLING Trans-Pac Drilling, Inc.

1980 Ft. from North Line and

CONTRACTOR

1980 Ft. from East Line of

ADDRESS Suite 600 - One Main Place

the NE/4 SEC. 32 TWP. 27S RGE. 20W

Wichita, KS 67202-1399


WELL PLAT

PLUGGING Trans-Pac Drilling, Inc.

CONTRACTOR

ADDRESS Suite 600 - One Main Place

Wichita, KS 67202-1399

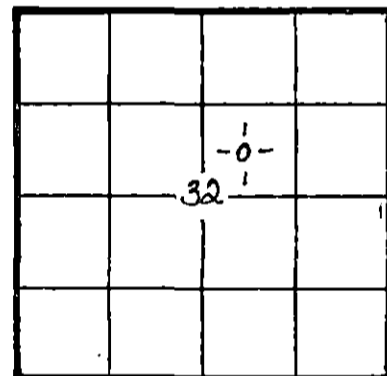

KCC
KGS
(Office Use)

TOTAL DEPTH 5000' PBTD

SPUD DATE Jan. 12, 1982 DATE COMPLETED Jan. 26, 1982

ELEV: GR 2308 DF KB

DRILLED WITH (CABLE) (ROTARY) (AIR) TOOLS

Amount of surface pipe set and cemented 631'

RECEIVED
DV STATE CORPORATION COMMISSION

FEB 18 1982
2-18-1982

CONSERVATION DIVISION
SS Wichita, Kansas

AFFIDAVIT

STATE OF Oklahoma, COUNTY OF Tulsa

Glen A. Gravander OF LAWFUL AGE, BEING FIRST DULY SWORN UPON HIS OATH,

DEPOSES THAT HE IS Assistant Production Mgr. (FOR) (OF) Deck Oil Co.

OPERATOR OF THE Pearson LEASE, AND IS DULY AUTHORIZED TO MAKE

THIS AFFIDAVIT FOR AND ON THE BEHALF OF SAID OPERATOR, THAT WELL NO. #1 ON

SAID LEASE HAS BEEN COMPLETED AS OF THE 26 DAY OF January, 1982, AND THAT

ALL INFORMATION ENTERED HEREIN WITH RESPECT TO SAID WELL IS TRUE AND CORRECT.

FURTHER AFFIANT SAITH NOT.

(S) *Glen A. Gravander*

SUBSCRIBED AND SWORN BEFORE ME THIS 16 DAY OF February, 1982

James J. Wallburn
NOTARY PUBLIC

MY COMMISSION EXPIRES: My Commission Expires January 31, 1984

**The person who can be reached by phone regarding any questions concerning this information. Within 45 days of completion, a witnessed initial test by the Commission is required if the well produces more than 25 BOPD or is located in a Basic Order Pool.

