

STATE CORPORATION COMMISSION OF KANSAS
OIL & GAS CONSERVATION DIVISION

WELL COMPLETION OR RECOMPLETION FORM
ACO-1 WELL HISTORY

DESCRIPTION OF WELL AND LEASE

Operator: license # 9854
name MarMac Petroleum Company
address 1026 Union Center Building
City/State/Zip Wichita, Kansas 67202

Operator Contact Person Doug McGinness II
Phone (316) 269-3424

Contractor: license # 5302
name Red Tiger Drilling Company

Wellsite Geologist Douglas H. McGinness II
Phone (316) 267-6065

PURCHASER Permian
Designate Type of Completion Kc-Kc-L

New Well Re-Entry Workover

Oil SWD Temp Abd
 Gas Inj Delayed Comp.
 Dry Other (Core, Water Supply etc.)

If OWWO: old well info as follows:

Operator
Well Name
Comp. Date
Old Total Depth

WELL HISTORY

Drilling Method: Mud Rotary Air Rotary Cable

02-02-86 02-11-86 03-26-86
Spud Date Date Reached TD Completion Date

4714' 4660'
Total Depth PBD

Amount of Surface Pipe Set and Cemented at 347 feet

Multiple Stage Cementing Collar Used? Yes No

If Yes, Show Depth Set feet

If alternate 2 completion, cement circulated
from feet depth to w/ SX cmt

RECEIVED
STATE CORPORATION COMMISSION

MAR 27 1986

API NO. 15-151-21,768-00-00
County Pratt
E/2 E/2 SW Sec 28 Twp 29S Rge 13 X W6
(location)

1320 Ft North from Southeast Corner of Section
2970 Ft West from Southeast Corner of Section
(Note: locate well in section plat below)


Lease Name Wright Well# 1

Field Name JEM Abandoned

Producing Formation Simpson Sand

Elevation: Ground 1900' KB 1905'

Section Plat

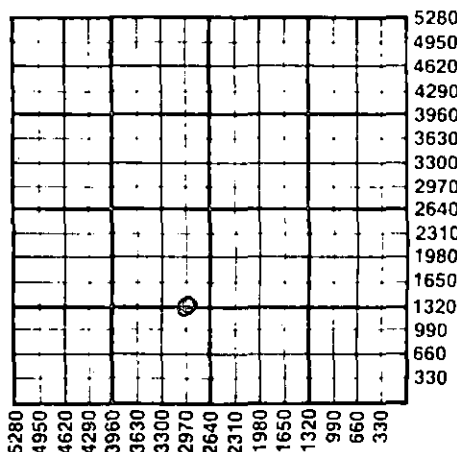

WATER SUPPLY INFORMATION

Source of Water:

Division of Water Resources Permit # T-86-72

Groundwater 990 Ft North From Southeast Corner of (Well) 2900 Ft. West From Southeast Corner Sec 28 Twp 29S Rge 13 East West

Surface Water Ft North From Southeast Corner of (Stream, Pond etc.) Ft West From Southeast Corner Sec Twp Rge East West

Other (explain) (purchased from city, R.W.D.#)

Disposition of Produced Water: Disposal Repressuring

Docket # CP-1782-KCC; C-19,243

INSTRUCTIONS: This form shall be completed in duplicate and filed with the Kansas Corporation Commission, 200 Colorado Derby Building, Wichita, Kansas 67202, within 90 days after completion or recompletion of any well. Rules 82-3-130 and 82-3-107 apply.

Information on side two of this form will be held confidential for a period of 12 months if requested in writing and submitted with the form. See rule 82-3-107 for confidentiality in excess of 12 months.

One copy of all wireline logs and drillers time log shall be attached with this form. Submit CP-4 form with all plugged wells. Submit CP-111 form with all temporarily abandoned wells.

All requirements of the statutes, rules, and regulations promulgated to regulate the oil and gas industry have been fully complied with and the statements herein are complete and correct to the best of my knowledge.

Signature [Signature] Title Secretary-Treasurer Date 03-27-86

Subscribed and sworn to before me this 27th day of March 19 86

Notary Public DeAnn Renee Konkell Date Commission Expires 04-08-89



K.C.C. OFFICE USE ONLY
 Letter of Confidentiality Attached
 Wireline Log Received
 Drillers Timelog Received
Distribution
 KCC SWD/Rep NGPA
 KGS Plug Other (Specify)

Form ACO-1 (7-84)

Sec. 28 Twp. 29S Rge. 13 W6