

AFFIDAVIT AND COMPLETION FORM

ACO-1

This form must be filed in triplicate with the Kansas Corporation Commission, 200 Colorado Derby Building, Wichita, Kansas 67202, within five days after the completion of the well, regardless of how the well was completed. Circle one: Oil, gas, (dry) SWD, OWWO, injection. Please type. Complete ALL sections. Applications must be filed for dual completion, commingling, salt water disposal and injection. Attach wireline logs (i.e. electrical log, sonic log, gamma ray neutron log, etc.) KCC#-(316) 263-3238.


OPERATOR Samuel Gary Oil Producer API NO. 15-057-20,235-0000
 ADDRESS Four Inverness Court East COUNTY Ford
Englewood, Colorado 80112-5599 FIELD Wildcat
 **CONTACT PERSON F. E. Farnham LEASE Keller Farm
 PHONE (303) 773-3800, ext. 230

PURCHASER N/A WELL NO. 23-14
 ADDRESS _____ WELL LOCATION C SE SW
660 Ft. from South Line and
1980 Ft. from West Line of
 the 23 SEC. 28 TWP. 23 RGE. West

DRILLING CONTRACTOR Big "A" Drilling
 ADDRESS 717 17th Street #2860
Denver, Colorado 80202

PLUGGING CONTRACTOR Halliburton
 ADDRESS P.O. Drawer 1431; Duncan, OK 73536

TOTAL DEPTH 5884' PBDT N/A
 SPUD DATE 10/4/81 DATE COMPLETED 10/20/81
 ELEV: GR 2475 DF 2484 KB 2485

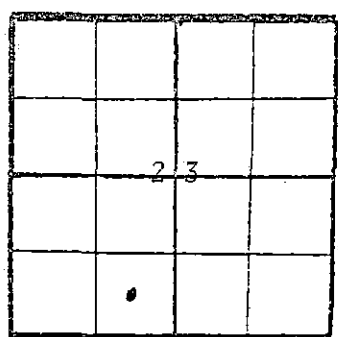

WELL PLAT
 (Quarter or Full) Section - Please indicate.

DRILLED WITH ~~(CABLE)~~ (ROTARY) ~~(AIR)~~ TOOLS
 Report of all strings set - surface, intermediate, production, etc. (New) / (Used) casing.

Purpose of string	Size hole drilled	Size casing set (in O.D.)	Weight lbs/ft.	Setting depth	Type cement	Sacks	Type and percent additives
Surface Casing	12 1/4"	8-5/8"	24#	554'	lite common	150 200	2% gel, 3% cc

LINER RECORD			PERFORATION RECORD		
Top, ft.	Bottom, ft.	Sacks cement	Shots per ft.	Size & type	Depth interval
		N/A			N/A

TUBING RECORD		
Size	Setting depth	Packer set at
		N/A

ACID, FRACTURE, SHOT, CEMENT SQUEEZE RECORD	
Amount and kind of material used	Depth interval treated

RECEIVED
 STATE CORPORATION COMMISSION
 DEC 21 1981
 12-21-1981
 CONSERVATION DIVISION
 Wichita Kansas

TEST DATE:		PRODUCTION	
Date of first production	Producing method (flowing, pumping, gas lift, etc.)	Oil	Gas
Plugged			
RATE OF PRODUCTION PER 24 HOURS	Water	Gas-oil ratio	CFPB
Disposition of gas (vented, used on lease or sold)	Producing interval(s)		

** The person who can be reached by phone regarding any questions concerning this information.
 A witnessed initial test by the Commission is required if the well produces more than 25 BOPD or is located in a Basic Order Pool.

Name of lowest fresh water producing stratum Ogallala Depth 370'
 Estimated height of cement behind pipe To surface

WELL LOG

Show all important zones of porosity and contents thereof; cased intervals and all drill-stem tests, including depth interval tested, cushion used, time tool open, flowing and shut-in pressures, and recoveries.

SHOW GEOLOGICAL MARKERS, LOGS RUN, OR OTHER DESCRIPTIVE INFORMATION

FORMATION DESCRIPTION, CONTENTS, ETC.	TOP	BOTTOM	NAME	DEPTH
<p>Geological report has been sent to Kansas Geological Survey. Samuel Gary Oil Producer is requesting that down-hole geological information including drill cuttings, all wireline logs, surveys, and driller's logs be kept in Confidential Status for a period of one (1) year from the date of receipt as indicated under Kansas Regulation 82-2-125.</p>				

USE ADDITIONAL SHEETS, IF NECESSARY, TO COMPLETE WELL RECORD.

A F F I D A V I T

STATE OF Colorado, COUNTY OF Denver SS,

F. E. Farnham OF LAWFUL AGE, BEING FIRST DULY SWORN UPON HIS OATH, DEPOSES AND SAYS:

THAT HE IS D & P Manager FOR Samuel Gary Oil Producer OPERATOR OF THE Keller Farms LEASE, AND IS DULY AUTHORIZED TO MAKE THIS AFFIDAVIT FOR AND ON BEHALF OF SAID OPERATOR, THAT WELL NO. 23-14 ON SAID LEASE HAS BEEN COMPLETED AS OF THE 20th DAY OF October 19 81, AND THAT ALL INFORMATION ENTERED HEREIN WITH RESPECT TO SAID WELL IS TRUE AND CORRECT.

FURTHER AFFIANT SAITH NOT.

(S) F. E. Farnham

SUBSCRIBED AND SWORN TO BEFORE ME THIS 15th DAY OF Dec. 19 81

Linda Haskell
 NOTARY PUBLIC

MY COMMISSION EXPIRES: My commission expires Oct 31, 1984